

J-5

12-14-60

WATER WELL DRILLERS LOG

J-301

Date: 12-14-1960, Driller: Quick & Sons, County: Pearl River

507-39

(Name)

CODED

(1) Owner of Land:	Description & Color of Materials Sand, Clay, Red Clay, Shell, etc.	Thick- ness Feet	Depth Feet
Justin Dillard (Name)	Surface clay	0	20
Crane Roads, Miss (Address)	Clay white	20	100
(2) Location: 1/4, 1/4, Sec. 24 T 3 R 18	Gravelly Sand	100	132
4 miles South of X Roads (distance) (direction) (Nearest Town)			
(3) Topography: X (Hilly) (Flat) (Level)			
(4) Purpose of Well: Domestic (Domestic Irrigation Municipal, Industrial, Other)			

Information upon completion of well:

- (1) Diameter 3 inches.
- (2) Total Depth 132 feet.
- (3) Water Level 88 feet below top of ground.
- (4) Cased to _____, Size _____
- (5) Screen: Size _____, Length _____
- (6) Were any formations sealed against pollution?
_____ yes, X no.


If YES depth of formation _____

Why _____

Drillers Remarks: Good well.

Cylinder Set 126"

13
CODED

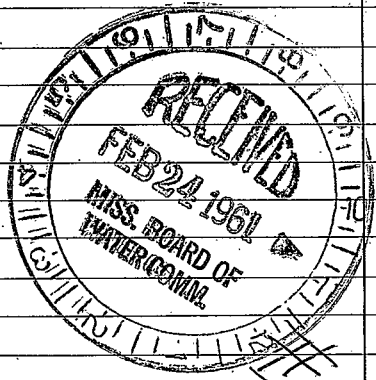

(Use Back Side)

Well No.

[Faint, illegible handwritten text, possibly bleed-through from the reverse side of the page]

[Large handwritten mark or signature]

[Handwritten numbers: 172/6]

[Handwritten numbers: 100]