

J-6

12-30-60

WATER WELL DRILLERS LOG

J-300
CODED

Date: 12-30, 1960, Driller: Quick & Price County: PEARL
(Name)

(1) Owner of Land: B. L. Sellers
(Name)
Cross Roads Miss.
(Address)

(2) Location: 1/4, 1/4, Sec. 14 T. 3R. 8.
20 miles west, of Poplarville
(distance) (direction) (Nearest Town)

(3) Topography: (Hilly) (Flat) (Level)

(4) Purpose of Well: Domestic
(Domestic Irrigation
Municipal, Industrial, Other)

Description & Color of Materials Sand, Clay, Red Clay, Shell, etc.	Thick- ness Feet	Depth Feet
<u>Surface clay.</u>	<u>0</u>	<u>10</u>
<u>Sand & gravel</u>	<u>10</u>	<u>40</u>
<u>white & blue clay.</u>	<u>40</u>	<u>90</u>
<u>good sand</u>	<u>90</u>	<u>132</u>

Information upon completion of well:

(1) Diameter 2 inches.

(2) Total Depth 132 feet.

(3) Water Level 4.5' feet below top of ground.

(4) Cased to _____, Size _____

(5) Screen: Size 2", Length 5'


(6) Were any formations sealed against pollution?
_____ yes, no.

132

If YES depth of formation _____

Why _____

Drillers Remarks: Good well

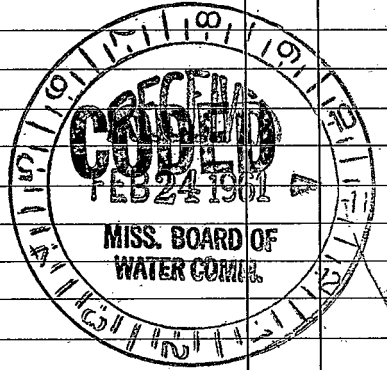

47

Well No.

(Use Back Side)

