

~~3-14-66~~ J-9

3-14-66

WATER WELL DRILLERS LOG

Date: 3/14, 1966, Driller: NEIL LUMPKIN  
MRS. EDD. W. BERGE County P.R.  
1877 (Name)

| (1) Owner of Land: MRS. EDD. W. BERGE<br>(Name)  | Description & Color of Materials<br>Sand, Clay, Red Clay, Shell, etc. | Thick-<br>ness<br>Feet | Depth<br>Feet |
|--|---|------------------------|---------------|
| POPLARVILLE<br>(Address)   | SURFACE CLAY  | 0                      | 10            |
|  | SAND  | 10                     | 80            |
|  | BLUE CLAY   | 80                     | 160           |
| (2) Location: 1/4, 1/4, Sec. 17 T3. R18  | Good SAND   | 160                    | 192           |
| 18 miles WEST of POPLARVILLE<br>(distance) (direction) (Nearest Town)                  |   |                        |               |
| (3) Topography: HILLY<br>(Hilly) (Flat) (Level)  |   |                        |               |
| (4) Purpose of Well: DOMESTIC<br>(Domestic Irrigation<br>Municipal, Industrial, Other) |   |                        |               |


Information upon completion of well:

- (1) Diameter 2 inches.
- (2) Total Depth 192 feet.
- (3) Water Level 15 feet below top of ground.
- (4) Cased to \_\_\_\_\_, Size \_\_\_\_\_
- (5) Screen: Size 2", Length 5'
- (6) Were any formations sealed against pollution?  
\_\_\_\_\_ yes,  no.

If YES depth of formation \_\_\_\_\_  
Why \_\_\_\_\_

Drillers Remarks: \_\_\_\_\_

CODED

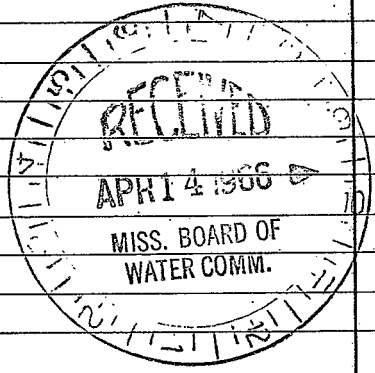

(Use Back Side)

Well No.

100

101

102

200