

PEARL RIVER
J-12
8-22-71

CODED

BOARD OF WATER COMMISSIONERS
 416 North State Street
 Jackson, Mississippi 39201

WATER WELL DRILLERS LOG

8-27 date well completed 21 Caskey Stafford Water Well Service firm name Pearl River county well located

LANDOWNER: Duane Wheat
Rt 1, Box 168
Carriere, Miss, 39426
 (mailing address)

description of formations encountered	from	to
Clay	0	68
Sand & Gravel	68	80

WELL LOCATION:
 sec. 23 T. 3 S. R. 14 W.
1 miles North of Harleyfield
 (distance) (direction) (nearest town)

WELL PURPOSE: home
 (home, irrigation, municipal, industrial)

- WELL COMPLETION DATA:
- (1) diameter (inches) 4
 - (2) total depth (feet) 80
 - (3) static water level (feet) 68 below top of ground.
 - (4) casing Plastic, 70 (material) (depth)
4 in if telescope see back. (size)
 - (5) screen 10, 70 (length) (depth to top)
4 in, Plastic (size) (material)
 - (6) pump 1/2, 900 (HP) (yield gpm) #
Elec. (type power)
 - (7) electric log _____ (yes or no)
 - _____ (organization running log)
 - (8) how well bottom plugged B.W.V.

CODED


SEP 7 1971

MISS. BD. OF
 WATER COMMISSIONERS

DRILLERS REMARKS:
J. S. Woodward

If well telescopes please sketch and show depths.

GROUND LEVEL

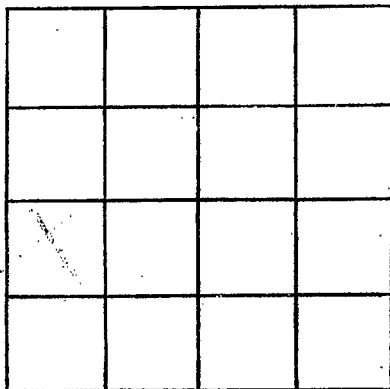

SECTION _____

Please indicate well location X.

ADDITIONAL INFORMATION

If more than one screen, show locations of each on sketch.