

Pearl River
 J 14
 3-28-75

MISSISSIPPI
 BOARD OF WATER COMMISSIONERS CODED
 416 North State Street
 Jackson, Mississippi 39201

WATER WELL DRILLERS LOG

pearl River

3-28-1975 date well completed
 Pearl River Water Well Drilling firm name
 Pearl River county well located

LANDOWNER:
 Mrs. C. L. Sells
 R.T. 1, Popperville, Miss.
 (mailing address)

description of formations encountered	from	to
Sand	0	18
Red chalf	18	25
Blue chalf	25	45
Fine sand	45	65
Coarser sand	65	90


WELL LOCATION:
 sec. 25 T. 3 N. R. 14 E
 20 miles East of Popperville, Miss.
 (distance) (direction) (nearest town)

WELL PURPOSE: Home
 (home, irrigation, municipal, industrial)

CODED

WELL COMPLETION DATA:

(1) diameter (inches) 4"
 (2) total depth (feet) 90
 (3) static water level (feet) _____ below/above top of ground.
 (4) casing P.V.C. 90 (material) (depth) _____ (size) if telescope see back.
 (5) screen 10 80 (length) (depth to top) _____ (size) Sch 40 (material)
 (6) pump 1/2 8 (HP) (yield gpm) _____ 220 V-AC (type power)
 (7) electric log _____ (yes or no)
 (organization running log) _____
 (8) how well bottom plugged 2 sand shock valve

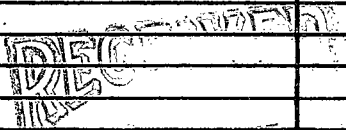


APR 14 1975

MISS. BD. OF WATER COMMISSIONERS

DRILLERS REMARKS:

If well telescopes please sketch and show depths.

GROUND LEVEL

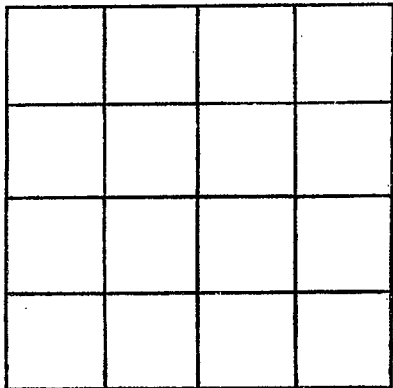

SECTION _____

Please indicate well location X.

ADDITIONAL INFORMATION

If more than one screen,
show locations of each on sketch.