

Pearl River  
J15  
12-67

MISSISSIPPI  
 BOARD OF WATER COMMISSIONERS  
 416 North State Street  
 130 Jackson, Mississippi 39201

WATER WELL DRILLERS LOG

**CODED**

12-4 date well completed      1967 Penkren Well Serv firm name      Pearl River county well located

LANDOWNER: John T. Charbonet

2103 American Bank Bldg

New Orleans La.  
 (mailing address)

WELL LOCATION:

sec. 13 T. 3 S. R. 18 W.  
1 1/2 miles East of Cross Roads  
 (distance) (direction) (nearest town)

WELL PURPOSE: Home  
 (home, irrigation, municipal, industrial)

WELL COMPLETION DATA:

(1) diameter (inches) 6 1/2 Drilled  
 (2) total depth (feet) 561  
 (3) static water level (feet) 5' below top of ground.

(4) casing Galv. Steel 546  
 (material) (depth)  
4" x 2" If telescope see back.  
 (size)

(5) screen 15' 546  
 (length) (depth to top)  
DIS 2" S. Steel  
 (size) (material)

(6) pump 2 60  
 (HP) (yield gpm)  
Elec  
 (type power)

(7) electric log NO  
 (yes or no)

(organization running log)


(8) how well bottom plugged B.W. Valve

description of formations encountered

from to

Red Clay	0	25
" SAND	25	40
SAND	40	73
White clay	73	126
SAND	126	190
Blue clay	190	306
Mud	306	345
Blue clay	345	510
Grey SAND	510	565

**CODED**

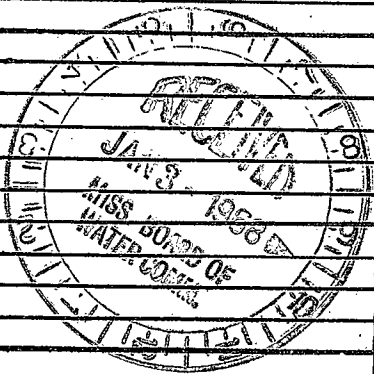

DRILLERS REMARKS:

