

Pearl River  
 J 16  
 8-2-68

MISSISSIPPI  
 BOARD OF WATER COMMISSIONERS  
 416 North State Street  
 Jackson, Mississippi 39201

CODED

WATER WELL DRILLERS LOG

8-2 1968 Patton Well Serv Pearl River  
 date well completed firm name county well located

LANDOWNER: Bill ~~Strahan~~  
 Rt. 1 Strahan  
 Poplarville Miss  
 (mailing address)


description of formations encountered	From	To
Clay	12	12
Sand + Gravel	12	70
Blue Clay	70	298
Grey Sand	298	335
Blue Clay	335	385
Grey Sand	385	580
Blue Clay	580	782
Grey Sand	782	835

WELL LOCATION:  
 sec. 14 T. 3 S. R. 18 E. W.  
 0 miles V. of Crossroads  
 (distance) (direction) (nearest town)

WELL PURPOSE: Irrigation  
 (home, irrigation, municipal, industrial)

- WELL COMPLETION DATA:
- (1) diameter (inches) 2"
  - (2) total depth (feet) 835
  - (3) static water level (feet) flow below above top of ground.
  - (4) casing Black steel 835'  
 (material) (depth)  
 2" (size) If telescope see back.
  - (5) screen 40' 795'  
 (length) (depth to top)  
 (size) (material)
  - (6) pump NO 50  
 (HP) (yield gpm)  
 (type power)
  - (7) electric log NO  
 (yes or no)  
 (organization running log)
  - (8) how well bottom plugged BW Valve


CODED

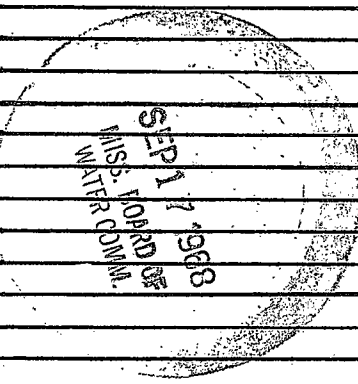

DRILLERS REMARKS: 40 Ft. Black Pipe Stotted with torch for screen 1/4" slots

If well telescopes please sketch and show depths.

GROUND LEVEL

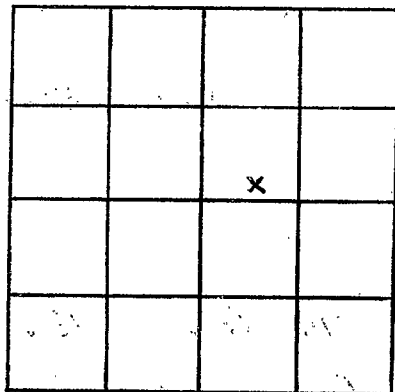

SECTION 124

Please indicate well location X.

ADDITIONAL INFORMATION

If more than one screen,  
show locations of each on sketch.