

MISSISSIPPI DEPARTMENT OF NATURAL RESOURCES

Bureau of Land and Water Resources

Southport Mall

P.O. Box 10631

Jackson, Mississippi 39209

WATER WELL DRILLERS LOG

Paul River  
~~10-26-82~~  
 10-26-82

J17

Oct 26 1982 Welton Welding Paul River  
 date well completed firm name county well located

LANDOWNER: Whart Roofing  
Cross Roads Miss  
RT 2 Poplarville  
 (mailing address)

description of formations encountered	from	to
red shale	0	6
gravel	6	55
Blue shale	55	195
sand	195	208
Blue shale	208	496
sand	496	554

WELL LOCATION:  
 sec. 6 T. 2 N. R. 18 E.  
3/4 miles N 26x12 3 HW  
 (distance) (direction) (nearest town)  
Cross Roads

WELL PURPOSE: home  
 (home, irrigation, municipal, industrial)

- WELL COMPLETION DATA:
- (1) diameter (inches) 2"
  - (2) total depth (feet) 554
  - (3) static water level (feet) 2 1/2 <sup>below</sup> above top of ground.
  - (4) casing PVC 539  
 (material) (depth)  
 (size) if telescope see back.
  - (5) screen 15' 539  
 (length) (depth to top)  
15' PVC Roped  
 (size) (material)
  - (6) pump no 10  
 (HP) (yield gpm)  
low flow  
 (type power)
  - (7) electric log \_\_\_\_\_  
 (yes or no)  
 (organization running log)
  - (8) how well bottom plugged Sand  
shut

*Pump installed*

DEPT. OF NATURAL RESOURCES  
 BUREAU OF LAND & WATER RESOURCES


NOV - 1 1982

RECEIVED

DRILLERS REMARKS:

If well telescopes please sketch and show depths.

GROUND LEVEL

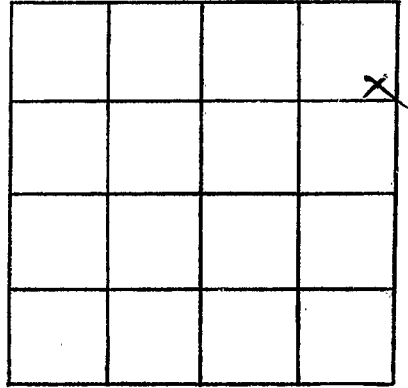

SECTION \_\_\_\_\_

Please indicate well location X.

ADDITIONAL INFORMATION

If more than one screen, show locations of each on sketch.