

Pearl River
 J 18
 9-30-76

MISSISSIPPI
 BOARD OF WATER COMMISSIONERS
 416 North State Street
 Jackson, Mississippi 39201

13V

WATER WELL DRILLERS LOG

Sept 30 1976 W. GRINER-GINN Pearl River
 date well completed firm name county well located

LANDOWNER:	description of formations encountered	from	to
PEARL RIVER BASIN			
Development Dist. (mailing address)	SAND	2	34
	CHALK + clay	34	290
	SAND	290	350
WELL LOCATION:			
sec. <u>16 T. 3 N</u> R. <u>18 E</u> S W			
<u>1</u> miles <u>E</u> of <u>Bogalusa</u> (distance) (direction) (nearest town)			
WELL PURPOSE: <u>WATER PARK</u> (home, irrigation, municipal, industrial)			
WELL COMPLETION DATA:			
(1) diameter (inches) <u>4"</u>			
(2) total depth (feet) <u>350'</u>			
(3) static water level (feet) <u>8</u> below above top of ground.			
(4) casing <u>P.</u> <u>330'</u> (material) (depth)			
<u>4"</u> (size) if telescope see back.			
(5) screen <u>20'</u> <u>330'</u> (length) (depth to top)			
<u>2"</u> <u>SS.</u> (size) (material)			
(6) pump <u>1 1/2</u> <u>259 gpm.</u> (HP) (yield gpm)			
<u>Elec</u> (type power)			
(7) electric log <u>NO</u> (yes or no)			
(organization running log)			
(8) how well bottom plugged <u>B.W. valve.</u>			
DRILLERS REMARKS:			


Are pump
 m. flow?
 Shut off

RECEIVED

OCT 12 1976

If well telescopes please sketch and show depths.

GROUND LEVEL

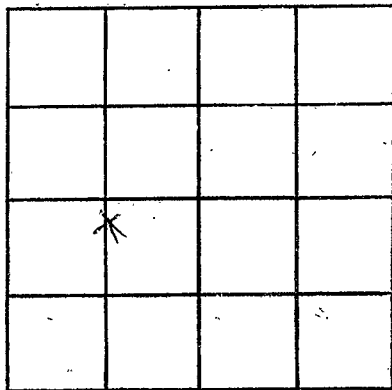

SECTION 16

Please indicate well location X.

ADDITIONAL INFORMATION

If more than one screen, show locations of each on sketch.