

**MISSISSIPPI  
BOARD OF WATER COMMISSIONERS**  
416 North State Street  
Jackson, Mississippi 39201

CODED

**WATER WELL DRILLERS LOG**

*Paul Rorie*  
*9/19*  
*6-26-69*

*June 26* 19*69* *Basley Staff and Paul Rorie* county well located

**LANDOWNER:**

*Minor Smith*  
*111 Poplarville Miss*  
(mailing address)

**description of formations encountered**

**from to**

<i>White Chalk</i>	<i>0</i>	<i>15'</i>
<i>sand + gravel</i>	<i>15'</i>	<i>92'</i>
<i>Blue Chalk</i>	<i>92'</i>	<i>170'</i>
<i>sand + gravel</i>	<i>170'</i>	<i>210'</i>

**WELL LOCATION:**

sec. *14* T. *3* N. R. *14* E.  
S W  
*1 1/2* miles *N* of *Basley*  
(distance) (direction) (nearest town)

**WELL PURPOSE:**

(home, irrigation, municipal, industrial)

**WELL COMPLETION DATA:**

- (1) diameter (inches) *2"*
- (2) total depth (feet) *210'*
- (3) static water level (feet) *15'* below above top of ground.
- (4) casing (material) (depth) (size) if telescope see back.
- (5) screen *30 ft, 130 ft* (length) (depth to top) *2" metal* (size) (material)
- (6) pump *2000 hp.* (HP) (yield gpm) (type power)
- (7) electric log *metal* (yes or no) (organization running log)
- (8) how well bottom plugged

*This is a flow well*


**AUG 7 1969**

**DRILLERS REMARKS:**

MISS. BD. OF  
WATER COMM.

If well telescopes please sketch and show depths.

GROUND LEVEL

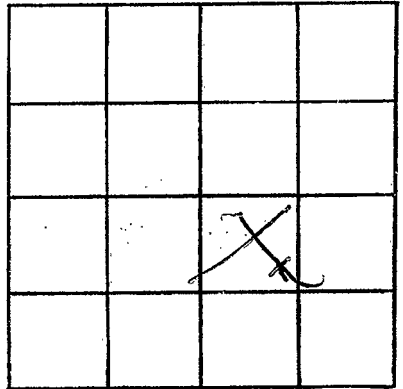

SECTION \_\_\_\_\_

Please indicate well location X.

ADDITIONAL INFORMATION

If more than one screen,  
show locations of each on sketch.