

**MISSISSIPPI  
BOARD OF WATER COMMISSIONERS**      CODED  
416 North State Street  
Jackson, Mississippi 39201

**WATER WELL DRILLERS LOG**

Pearl River  
J 20  
6-28-69

June 28 1969 Easley Stafford Pearl River  
date well completed      firm name      county well located


LANDOWNER:	description of formations encountered	from	to
<u>Oliver Smith</u>			
<u>Rt. 1, Poplarville, Miss</u> (mailing address)	<u>White Chalk</u>	<u>0</u>	<u>15'</u>
	<u>Sand + Gravel</u>	<u>15'</u>	<u>92'</u>
	<u>Blue Chalk</u>	<u>92'</u>	<u>170'</u>
	<u>Sand + Gravel</u>	<u>170'</u>	<u>210'</u>
<b>WELL LOCATION:</b>			
sec. <u>4</u> T <u>3</u> N R <u>19</u> E S W			
<u>1 1/2</u> miles <u>W</u> of <u>Crossland</u> (distance) (direction) (nearest town)			
<b>WELL PURPOSE:</b> (home, irrigation, municipal, industrial)			
<b>WELL COMPLETION DATA:</b>			
(1) diameter (inches) <u>2"</u>			
(2) total depth (feet) <u>210'</u>			
(3) static water level (feet) <u>15 ft</u> below top of ground.	<u>This is a flow well</u>		
(4) casing (material) (depth) (size) if telescope see back.			
(5) screen <u>30 ft</u> , <u>170 ft</u> (length) (depth to top) <u>2"</u> <u>metal</u> (size) (material)			
(6) pump <u>2,000 hp</u> (HP) (yield gpm) (type power)			
(7) electric log <u>NO</u> (yes or no) (organization running log)			
(8) how well bottom plugged			

DRILLERS REMARKS:

AUG 7 1969  
MISS. BD. OF WATER

If well telescopes please sketch and show depths.

GROUND LEVEL

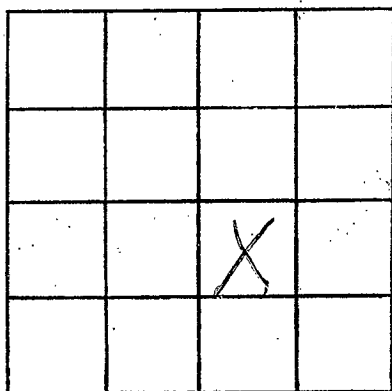

SECTION \_\_\_\_\_

Please indicate well location X.

ADDITIONAL INFORMATION

If more than one screen,  
show locations of each on sketch.