

Pearl River
921
6-30-69

MISSISSIPPI
 BOARD OF WATER COMMISSIONERS
 416 North State Street
 Jackson, Mississippi 39201

CODED

WATER WELL DRILLERS LOG

6-30 1969 Metehan's Water Well Service Pearl River
 date well completed firm name county well located

LANDOWNER: Mrs Mary
Maie Walker
RT#1 Poplarville, Miss
 (mailing address)

description of formations encountered	from	to
	<u>Clay</u>	<u>0'</u>
<u>fine sand</u>	<u>18'</u>	<u>28'</u>
<u>Coarse sand</u>	<u>28'</u>	<u>42'</u>

WELL LOCATION:
 sec 9 T 3 N R 18 E
1 1/2 miles SW of Poplarville
 (distance) (direction) (nearest town)

WELL PURPOSE: None
 (home, irrigation, municipal, industrial)

- WELL COMPLETION DATA:
- diameter (inches) 2"
 - total depth (feet) 42'
 - static water level (feet) 12 below ~~above~~ top of ground.
 - casing PVC 42'
 (material) (depth)
 (size) If telescope see back.
 - screen 5' 37'
 (length) (depth to top)
2" PVC
 (size) (material)
 - pump 1/2 8
 (HP) (yield gpm)
Electric
 (type power)
 - electric log NO
 (yes or no)
- (organization running log)
- (8) how well bottom plugged Bank Pressure
Value


MISS. 3-1103

MISS. BD. OF
 WATER COMMISSIONERS

DRILLERS REMARKS:

If well telescopes please sketch and show depths.

GROUND LEVEL

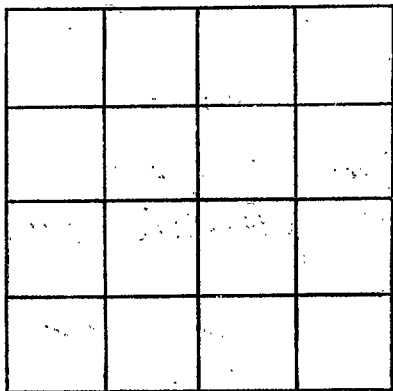

SECTION _____

Please indicate well location X.

ADDITIONAL INFORMATION

If more than one screen,
show locations of each on sketch.