

CODED

MISSISSIPPI
BOARD OF WATER COMMISSIONERS
416 North State Street
Jackson, Mississippi 39201

WATER WELL DRILLERS LOG

Pearl River
J22
4-3-69

4-3-69 19 HAROLD HOODWARD WATERWEL PEARL RIVER
date well completed firm name county well located *Conn*

LANDOWNER: W. H. WARD Jr.

description of formations encountered from to

New Orleans, La.
(mailing address)

Red Clay 0 14'-

WELL LOCATION:
sec. 11 T 3 N 18 E
(S) (W)

White Sand 18' 25'

4 1/8 miles North of Cosmos
(distance) (direction) (nearest town)

Small rock sand 25' 40'

WELL PURPOSE: HOME
(home, irrigation, municipal, industrial)

White Clay 40' 50'

WELL COMPLETION DATA:

(1) diameter (inches) 2"

set at 40ft-

(2) total depth (feet) 40ft-

(3) static water level (feet) 12' below top of ground.

(4) casing plastic
(material) (depth)

_____ If telescope see back.
(size)

(5) screen 5ft-
(length) (depth to top)

1 1/4" plastic
(size) (material)

(6) pump 3 450
(HP) (yield gpm)

110 AC
(type power)

(7) electric log yes
(yes or no)

Self
(organization running log)


(8) how well bottom-plugged 1 1/4"
Small amount Blue Seal

[Handwritten signatures]

DRILLERS REMARKS: This well
will not be use but 2 or
3 time per year

If well telescopes please sketch and show depths.

GROUND LEVEL

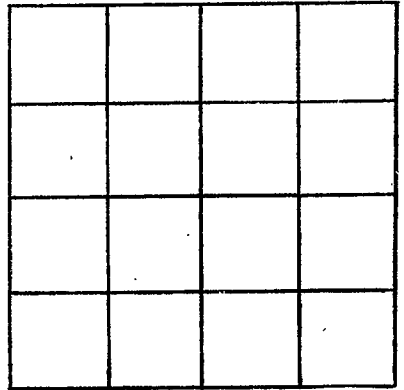

SECTION 11

Please indicate well location X.

ADDITIONAL INFORMATION

I don't know what section of land we were on the land owner was not with us.

H. Woodhead

If more than one screen, show locations of each on sketch.