

Pearl River
J 23
6-12-69

MISSISSIPPI
 BOARD OF WATER COMMISSIONERS
 416 North State Street
 Jackson, Mississippi 39201

CODED

WATER WELL DRILLERS LOG

June 12 1969 Harold Woodward Pearl River
 date well completed firm name county well located
Water Well Drilling

LANDOWNER: Ornel Brumby description of formations encountered from to
1st. 1 50' 85'

Papillion, Miss. 50' sand brown
 (mailing address)

WELL LOCATION: 60' white sand
 sec. 12 T. 3 N R. 18 E
~~X5~~ ~~XW~~
2.9 miles NE of Crossroads 25' hard choice sand
 (distance) (direction) (nearest town) 2' gravel

WELL PURPOSE: HOME
 (home, irrigation, municipal, industrial)

WELL COMPLETION DATA:

- (1) diameter (inches) 4"
- (2) total depth (feet) 85 FT.
- (3) static water level (feet) 33 FT. below top of ground.
- (4) casing plastic 80 FT.
 (material) (depth)
 if telescope see back.
 (size)
- (5) screen 10 FT.
 (length) (depth to top) Set out 85 ft.
4" plastic
 (size) (material)
- (6) pump 1/2 580
 (HP) (yield gpm)
115 AC
 (type power)
- (7) electric log no
 (yes or no)
Self
 (organization running log)
- (8) how well bottom plugged Bl. / Mud

JUN 27 1969


MISS. BD. OF
 WATER COMM.

DRILLERS REMARKS: None

If well telescopes please sketch and show depths.

GROUND LEVEL

*I don't have a
land section map for
Pearl River County
Havild
Woodward*

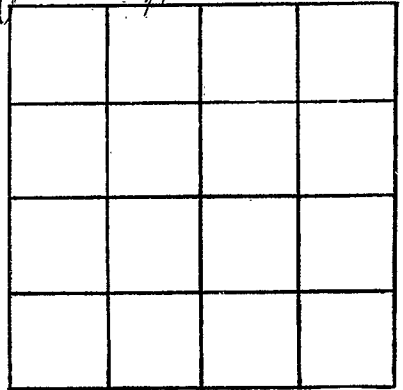

SECTION _____

Please indicate well location X.

ADDITIONAL INFORMATION

If more than one screen,
show locations of each on sketch.