

Pearl River
 J 24
 3-21-20

MISSISSIPPI
 BOARD OF WATER COMMISSIONERS
 416 North State Street
 Jackson, Mississippi 39201

COMM

WATER WELL DRILLERS LOG

3-21 1970 Pearlton Well Serv Pearl River
 date well completed firm name county well located

LANDOWNER: S.C. Pearlton
 Rt. 1 Box 168
 Poplarville Miss
 (mailing address)

description of formations encountered	from	to
Surface clay	0	16
Sand + Gravel	16	42
White Clay	42	48
Blue clay	48	208
Grey Sand	208	234

WELL LOCATION:
 sec 4 T 3 R 18
 2 miles North of Crossroads
 (distance) (direction) (nearest town)

WELL PURPOSE: Home
 (home, irrigation, municipal, industrial)

WELL COMPLETION DATA: 4" in

- (1) diameter (inches) 2"
- (2) total depth (feet) 234
- (3) static water level (feet) 8 above top of ground.
- (4) casing Galv, 229, (material) (depth)
 2" if telescope see back. (size)
- (5) screen 5', 229, (length) (depth to top)
 2", 3. Steel, (size) (material)
- (6) pump (HP) (yield gpm)
 (type power)
- (7) electric log NO (yes or no)
 (organization running log)
- (8) how well bottom plugged Bell Valve

CODED


APR - 1 1970

DRILLERS REMARKS:

MISS. BD. OF
 WATER COMM.

If well telescopes please sketch and show depths.

GROUND LEVEL

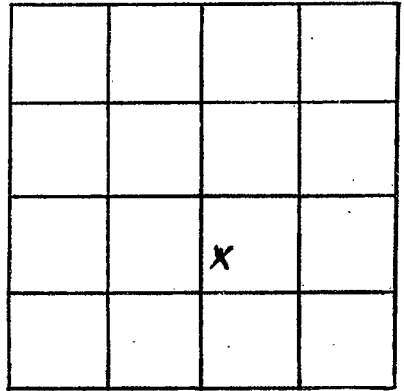

SECTION 4

Please indicate well location X.

ADDITIONAL INFORMATION

If more than one screen, show locations of each on sketch.