

PEARL RIVER
J 25
8-7-70

MISSISSIPPI
 BOARD OF WATER COMMISSIONERS
 416 North State Street
 Jackson, Mississippi 39201
 WATER WELL DRILLERS LOG

CODED

8-7 1970 Horace A Poole Pearl River
 date well completed firm name county well located

LANDOWNER: David Smith
Carriete Miss
RT
 (mailing address)

description of formations encountered	from	to
<u>Surface Clay</u>	<u>0</u>	<u>20</u>
<u>SAND + CLAY</u>	<u>20</u>	<u>40</u>
<u>CLAY</u>	<u>40</u>	<u>230</u>
<u>SAND</u>	<u>230</u>	<u>252</u>

WELL LOCATION:
 sec. 35 T 3 R 18 E
 (S) W
12 miles E of Logansport
 (distance) (direction) (nearest town)

WELL PURPOSE:
 (home, irrigation, municipal, industrial)

- WELL COMPLETION DATA:
- (1) diameter (inches) 4"
 - (2) total depth (feet) 252
 - (3) static water level (feet) 160' below top of ground.
 - (4) casing PVC, 240,
 (material) (depth)
2" if telescope see back.
 (size)
 - (5) screen 5", 240"
 (length) (depth to top)
2", PVC
 (size) (material)
 - (6) pump 1 1/2 6
 (HP) (yield gpm)
elec
 (type power)
 - (7) electric log no
 (yes or no)
- (organization running log)
- (8) how well bottom plugged BACKWASH VALVE


CODED

DRILLERS REMARKS:

SEP 4 1970

If well telescopes please sketch and show depths.

GROUND LEVEL

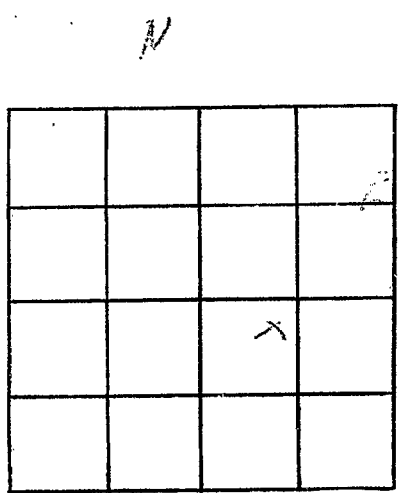

SECTION 35

Please indicate well location X.

ADDITIONAL INFORMATION

If more than one screen, show locations of each on sketch.