

PEARL RIVER

J 29

4-14-71

MISSISSIPPI BOARD OF WATER COMMISSIONERS 416 North State Street Jackson, Mississippi 39201

CODED

WATER WELL DRILLERS LOG

April 14 1971 date well completed

R. Woodward Drilling firm name

Pearl River county well located

LANDOWNER: Clyde Miller

description of formations encountered

from

to

Poplarville, Miss (mailing address)

orange and white clay

30'

fine blue sand

35 45'

Brown sand

45 60

white sand gravel

50 83'

clay

83

WELL LOCATION:

sec. 13 T. 3 S R. 18 W

miles of (distance) (direction) (nearest town)

WELL PURPOSE:

(home, irrigation, municipal, industrial)

WELL COMPLETION DATA:

- (1) diameter (inches) 2
(2) total depth (feet) 83
(3) static water level (feet) 35 below top of ground.
(4) casing Plastic 78 (material) (depth)
2" (size) If telescope see back.
(5) screen 5' 78' (length) (depth to top)
2" Plastic (size) (material)
(6) pump None at time of completion (HP) (yield gpm)
(type power)
(7) electric log No (yes or no)

CODED

APR 19 1971

MISS. RD. OF WATER COMMISSIONERS


(organization running log)

(8) how well bottom plugged Float Type BWW

DRILLERS REMARKS:

If well telescopes please sketch and show depths.

GROUND LEVEL

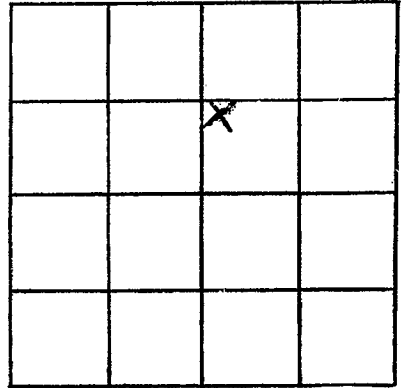

SECTION 13

Please indicate well location X.

ADDITIONAL INFORMATION

If more than one screen,
show locations of each on sketch.