

PEARL RIVER
 J 30
 8-12-71

MISSISSIPPI
 BOARD OF WATER COMMISSIONERS
 416 North State Street
 Jackson, Mississippi 39201

CODED

WATER WELL DRILLERS LOG

8-12-71 date well completed
 1971 Mc Sherris Water Well Service Pearl River firm name
 county well located

LANDOWNER: Jiggie Wheat
Rt # 1 Poplarville
Miss
 (mailing address)

description of formations encountered	from	to
<u>Clay</u>	<u>0</u>	<u>10</u>
<u>Sand</u>	<u>10</u>	<u>47</u>

WELL LOCATION:
 sec. 11 T. 3 S. R. 18 W.
1/2 miles NE of Crossroads
 (distance) (direction) (nearest town)

WELL PURPOSE: home
 (home, irrigation, municipal, industrial)

- WELL COMPLETION DATA:
- (1) diameter (inches) 2
 - (2) total depth (feet) 47'
 - (3) static water level (feet) 5 below top of ground.
 - (4) casing PVC, 47'
 (material) (depth)
 (size) if telescope see back.
 - (5) screen 5', 42'
 (length) (depth to top)
2", PVC
 (size) (material)
 - (6) pump 1/2, 15
 (HP) (yield gpm)
Electric
 (type power)
 - (7) electric log no
 (yes or no)

CODED

(organization running log)
 (8) how well bottom plugged back
Pressure Valve


NOV 15 1971

MISS. BD. OF
 WATER COMM.

DRILLERS REMARKS:

If well telescopes please sketch and show depths.

GROUND LEVEL

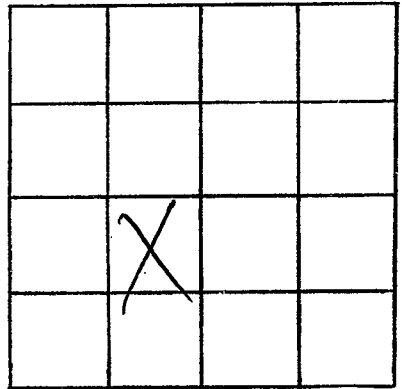

SECTION 3

Please indicate well location X.

ADDITIONAL INFORMATION

If more than one screen, show locations of each on sketch.