

PEARL RIVER
J 1031
11-20-71

MISSISSIPPI
 BOARD OF WATER COMMISSIONERS
 416 North State Street
 Jackson, Mississippi 39201

CODED

DEC 15 1971

WATER WELL DRILLERS LOG

MISS. BD. OF

11-20
 date well completed

19 71 Panton Well Serv
 firm name

Pearl River
 county well located

LANDOWNER: <u>Mike Charbonette</u>	description of formations encountered	from	to
<u>2103 American Bank Bldg</u>	<u>Surface clay</u>	<u>0</u>	<u>28</u>
<u>New Orleans La</u> (mailing address)	<u>White Sand</u>	<u>28</u>	<u>100</u>
	<u>Blue Clay</u>	<u>100</u>	<u>120</u>
	<u>Sand</u>	<u>120</u>	<u>180</u>
	<u>Blue Clay</u>	<u>180</u>	<u>490</u>
	<u>Sand</u>	<u>490</u>	<u>575</u>
WELL LOCATION:			
sec. <u>13</u> T <u>3</u> N R <u>18</u> E S W			
<u>1</u> miles <u>East</u> of <u>Crossroads</u> (distance) (direction) (nearest town)			
WELL PURPOSE: <u>Farm Pond</u> (home, irrigation, municipal, industrial)			
WELL COMPLETION DATA:			
(1) diameter (inches) <u>6x4x3</u>			
(2) total depth (feet) <u>575</u>			
(3) static water level (feet) <u>2</u> below top of ground. above			
(4) casing <u>Galv.</u> , <u>555</u> (material) (depth)			
(size) if telescope see back.			
(5) screen <u>20</u> , <u>555</u> (length) (depth to top)			
<u>3x2 1/2 x 2</u> , <u>S. Steel</u> (size) (material)			
(6) pump <u>5</u> , <u>165</u> (HP) (yield gpm)			
<u>Elec</u> (type power)			
(7) electric log <u>NO</u> (yes or no)			
(organization running log)			
(8) how well bottom plugged <u>BU. Valve</u>			
DRILLERS REMARKS:			


CODED

If well telescopes please sketch and show depths.

GROUND LEVEL

5'-2M-5'-2 1/2-10'-3"
330'-3"
105'-4"
120'-6"

#013 slot

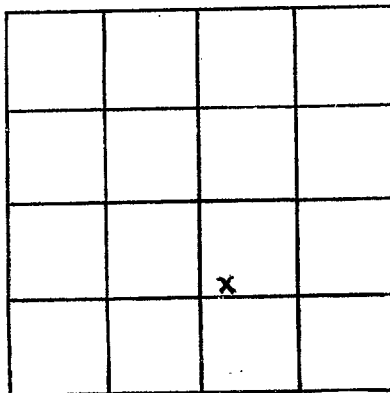

SECTION 13

Please indicate well location X.

ADDITIONAL INFORMATION

If more than one screen, show locations of each on sketch.