

PEARL RIVER
 J 35
 1-23-73

MISSISSIPPI
 BOARD OF WATER COMMISSIONERS
 416 North State Street
 Jackson, Mississippi 39201

CODED

WATER WELL DRILLERS LOG

1-23-1973 date well completed
 Mc Shivers Water Well Pearl River firm name
 Pearl River county well located

LANDOWNER: R. B. Carter
 Rt #1 Poplarville
 Miss
 (mailing address)

| description of formations encountered | from | to |
|---------------------------------------|------|-----|
| Top Soil | 0 | 15 |
| Shale + Pea Gravel | 15 | 65 |
| Clay | 65 | 210 |
| Shale | 210 | 219 |
| Clay | 219 | 325 |
| Shale | 325 | 405 |

WELL LOCATION:
 15 Sec. 9 T. 9 N. R. 18 E. W.
 3/4 miles (distance) 3 W (direction) of Crossroad (nearest town)

WELL PURPOSE: home
 (home, irrigation, municipal, industrial)

WELL COMPLETION DATA:

- (1) diameter (inches) 2
- (2) total depth (feet) 405
- (3) static water level (feet) 12 ^{below} above top of ground.
- (4) casing Steel 405
 (material) (depth)
— if telescope see back.
 (size)
- (5) screen 4" 401
 (length) (depth to top)
2" Stainless Steel
 (size) (material)
- (6) pump 1/2 15
 (HP) (yield gpm)
Electric
 (type power)
- (7) electric log no
 (yes or no)

CODED

(organization running log)


(8) how well bottom plugged Back
Pressure Valve

DRILLERS REMARKS:

PEARL RIVER

If well telescopes please sketch and show depths.

GROUND LEVEL

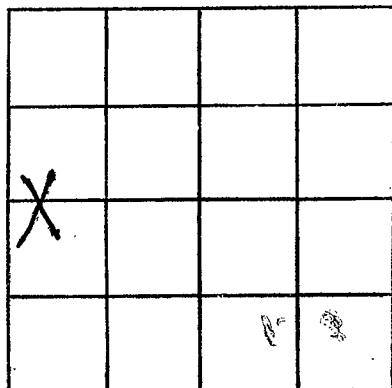

SECTION

~~0~~ 3

Please indicate well location X.

ADDITIONAL INFORMATION

If more than one screen, show locations of each on sketch.