

P. R.
 J 37
 10-15-73

MISSISSIPPI
 BOARD OF WATER COMMISSIONERS
 416 North State Street
 Jackson, Mississippi 39201

CODED

WATER WELL DRILLERS LOG

10-15-73 19 Enslin Stafford water wells, Pearl River Co.
 date well completed firm name county well located

LANDOWNER: Robert Dillon
Rt-1 Box 240
Poplarville Miss
 (mailing address)

WELL LOCATION:
 sec. 24 T. 3 N. R. 18 E.
Three miles South of crossroads
 (distance) (direction) (nearest town)

WELL PURPOSE:
 (home, irrigation, municipal, industrial)

WELL COMPLETION DATA:
 (1) diameter (inches) 4
 (2) total depth (feet) 105
 (3) static water level (feet) 20 below above top of ground.
 (4) casing 4 95
 (material) (depth)
4 if telescope see back.
 (size)
 (5) screen 10 95
 (length) (depth to top)
4 Plastic
 (size) (material)
 (6) pump 1/2 H.P. 10
 (HP) (yield gpm)
Elec.
 (type power)
 (7) electric log ~~yes~~
 (yes or no)
 (organization running log)
 (8) how well bottom plugged B.W.V.

description of formations encountered	from	to
Top soil	0	12
Chalk	12	36
Sand	36	48
Chalk	48	72
Sand & Gravel	72	105


CODED

DRILLERS REMARKS:
Cleve Duran

NOV 20 1973

If well telescopes please sketch and show depths.

GROUND LEVEL

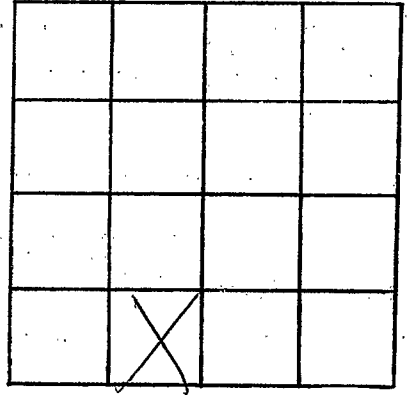

SECTION 24

Please indicate well location X.

ADDITIONAL INFORMATION

If more than one screen,
show locations of each on sketch.