

P.R.  
J 39  
9-26-73

MISSISSIPPI  
BOARD OF WATER COMMISSIONERS  
416 North State Street  
Jackson, Mississippi 39201

Oct 26 1973

OK  
CODED

WATER WELL DRILLERS LOG

*Reynolds*  
Lumpkin Well Ser. Pearl River

9-26-1973 date well completed  
Lumpkin Well Ser. firm name  
Pearl River county well located

LANDOWNER: <i>Mar. Annie Kadet</i>	description of formations encountered	from	to
<i>Rt. 1</i>			
<i>Carrine, Mrs.</i> (mailing address)	<i>20K</i>		
WELL LOCATION: sec. <i>24</i> T. <i>3</i> N. R. <i>18</i> E. <i>3</i> miles S of <i>Cross Roads</i>	<i>Surface clay</i>	<i>0</i>	<i>10</i>
(distance) (direction) (nearest town)	<i>Sand &amp; gravel</i>	<i>10</i>	<i>60</i>
WELL PURPOSE: <i>None</i> (home, irrigation, municipal, industrial)	<i>Blue clay</i>	<i>60</i>	<i>190</i>
	<i>Good Sand</i>	<i>190</i>	<i>237</i>

WELL COMPLETION DATA:

(1) diameter (inches) *2"*

(2) total depth (feet) *237*

(3) static water level (feet) *170'* below top of ground.

(4) casing *Gal.*, *232'*  
(material) (depth)  
*2"* if telescope see back.  
(size)

(5) screen *5'*, *232'*  
(length) (depth to top)  
*2"*, *S.S.*  
(size) (material)

(6) pump *2 h.p.*, *280 G.P.M.*  
(HP) (yield gpm)  
*E. line.*  
(type power)

(7) electric log *no.*  
(yes or no)

(organization running log)

(8) how well bottom plugged *David Smith*


CODED

DRILLERS REMARKS: *OCT 26 1973*

MISS. RD. (1)  
WATER COM. (1)

If well telescopes please sketch and show depths.

GROUND LEVEL

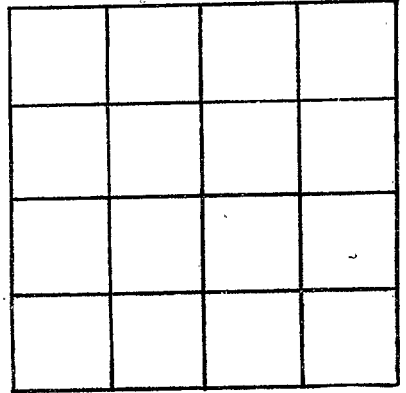

SECTION \_\_\_\_\_

Please indicate well location X.

ADDITIONAL INFORMATION

If more than one screen,  
show locations of each on sketch.