

MISSISSIPPI
 BOARD OF WATER COMMISSIONERS
 416 North State Street
 Jackson, Mississippi 39201
 HAROLD WOODWARD
 WATER WELL DRILLERS LOG

CODED

Pearl River
 J 40
 2/5/74

Feb 5 1974 ~~Miss. State Water Drilling~~ ^{Co. Inc.} Pearl River
 date well completed firm name county well located

LANDOWNER Albery Smith
Box 252
poplarville, Miss.
 (mailing address)

description of formations encountered	from	to
Red Clay	0	18
fine sand	18	24
Choker Sand	18	24
White clay	24	32
	33ft	

WELL LOCATION:
 sec. 35 T. 3^S R. 18
3 miles S of Chickasaw
 (distance) (direction) (nearest town)

WELL PURPOSE:
 (home, irrigation, municipal, industrial)

WELL COMPLETION DATA:
 (1) diameter (inches) 2"
 (2) total depth (feet) 30'
 (3) static water level (feet) 26 below above top of ground.
 (4) casing plastic 25'
 (material) (depth)


If telescope see back.
 (size)
 (5) screen 5' 25'
 (length) (depth to top)
2" plastic
 (size) (material)
 (6) pump 1/2 3
 (HP) (yield gpm)

11.5" AC
 (type power)
 (7) electric log NO
 (yes or no)
Harold Woodward
 (organization running log)

(8) how well bottom plugged 2" SS


DRILLERS REMARKS:

CODED

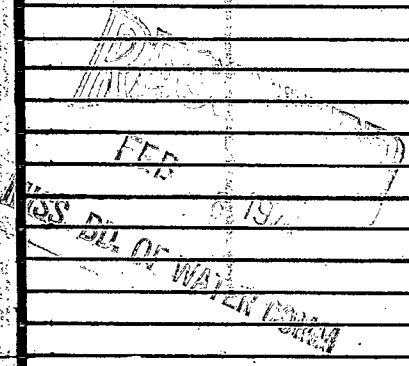

If well telescopes please sketch and show depths.

GROUND LEVEL

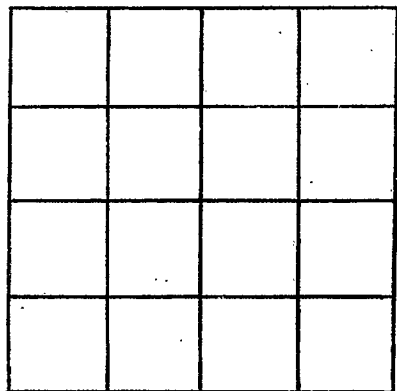

SECTION _____

Please indicate well location X.

ADDITIONAL INFORMATION

If more than one screen,
show locations of each on sketch.