

Pearl River
J 41
8-15-73

MISSISSIPPI
 BOARD OF WATER COMMISSIONERS
 416 North State Street
 Jackson, Mississippi 39201

WATER WELL DRILLERS LOG

8-15 1973 McAdams Water Well Drilling Pearl River
 date well completed firm name county well located

LANDOWNER: Veeva Construction Co
P.O. Box 546 Bogalusa, La
 (mailing address)

description of formations encountered	from	to
<u>Tap fail</u>	<u>0</u>	<u>2</u>
<u>Shale + pea gravel</u>	<u>2</u>	<u>63</u>

WELL LOCATION:
 sec. 8 T. 3 R. 18
19 miles N of Crossroad
 (distance) (direction) (nearest town)

WELL PURPOSE: Industrial
 (home, irrigation, municipal, industrial)

WELL COMPLETION DATA:

(1) diameter (inches) 4"

(2) total depth (feet) 63'

(3) static water level (feet) 28 below above top of ground.

(4) casing PVC 63'
 (material) (depth)

 if telescope see back.
 (size)

(5) screen 20' 43'
4" (length) (depth to top)
 (size) PVC (material)

(6) pump 5 96
 (HP) (yield gpm)
Electric
 (type power) no

(7) electric log
 (yes or no)

 (organization running log)


(8) how well bottom plugged Back Pressure Valve

CODED

DRILLERS REMARKS:

If well telescopes please sketch and show depths.

GROUND LEVEL

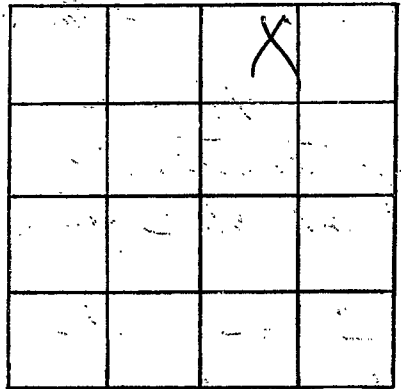

SECTION 9

Please indicate well location X.

ADDITIONAL INFORMATION

If more than one screen, show locations of each on sketch.