

Pearl River
J 42
2-16-77

MISSISSIPPI
 BOARD OF WATER COMMISSIONERS CODED
 416 North State Street
 Jackson, Mississippi 39201

WATER WELL DRILLERS LOG

2-16 1977 Mc Shens Water Well Pearl River
 date well completed firm name county well located

LANDOWNER: Vision Construction
Box 576 Bogalusa, La
 (mailing address)

description of formations encountered	from	to
<u>top soil</u>	<u>0</u>	<u>2</u>
<u>Sand + gravel</u>	<u>2</u>	<u>63</u>

WELL LOCATION:
 sec 3 T 3 R 16
19 miles N of Crossroad
 (distance) (direction) (nearest town)

WELL PURPOSE: Industrial
 (home, irrigation, municipal, industrial)

WELL COMPLETION DATA:

(1) diameter (inches) 4"

(2) total depth (feet) 63

(3) static water level (feet) 2 below above top of ground.

(4) casing PVC PVC
 (material) (depth)

(size) if telescope see back.

(5) screen 40' 23'
 (length) (depth to top)

4" PVC
 (size) (material)

(6) pump 5 200
 (HP) (yield gpm)


Electric
 (type power)

(7) electric log No
 (yes or no)

(organization running log)

(8) how well bottom plugged Back
wash valve


CODED

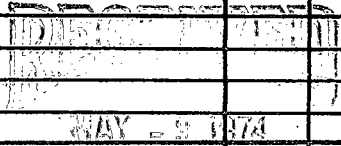

DRILLERS REMARKS:

If well telescopes please sketch and show depths.

GROUND LEVEL

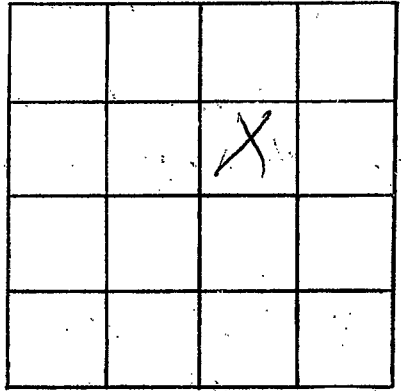

SECTION 9

Please indicate well location X.

ADDITIONAL INFORMATION

If more than one screen, show locations of each on sketch.