

Pearl River
J43
3-5-74

MISSISSIPPI
 BOARD OF WATER COMMISSIONERS
 416 North State Street
 Jackson, Mississippi 39201

CODED

WATER WELL DRILLERS LOG

3-5 1974 Mc Elhairs Water Well Pearl River
 date well completed firm name county well located

LANDOWNER: Bethal Church
Rt 1 Poplarville, Miss
 (mailing address)

| description of formations encountered | from | to |
|---------------------------------------|-----------|-----------|
| <u>Top Soil + clay</u> | <u>0</u> | <u>10</u> |
| <u>Sand + Pea gravel</u> | <u>10</u> | <u>32</u> |

WELL LOCATION:
5 T 3 N R 18 E
2 miles NE of crossroad
 (distance) (direction) (nearest town)

WELL PURPOSE: home
 (home, irrigation, municipal, industrial)

WELL COMPLETION DATA:

(1) diameter (inches) 4"

(2) total depth (feet) 32'

(3) static water level (feet) 10' below above top of ground.

(4) casing PVC 32'
 (material) (depth)
 (size) if telescope see back.

(5) screen 10' 22'
 (length) (depth to top)
4" PVC
 (size) (material)

(6) pump 1/2 7
 (HP) (yield gpm)
Electric
 (type power)

(7) electric log no
 (yes or no)

(organization running log)


(8) how well bottom plugged Back Wash Valve

CODED

DRILLERS REMARKS:

If well telescopes please sketch and show depths.

GROUND LEVEL

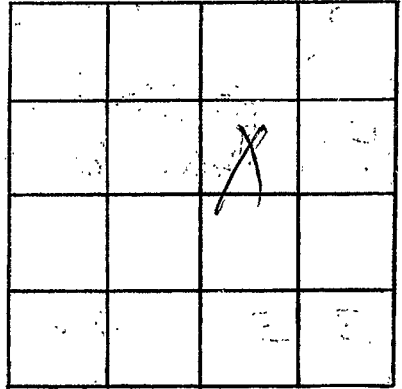

SECTION 5

Please indicate well location X.

ADDITIONAL INFORMATION

If more than one screen, show locations of each on sketch.