

Pearl River
 J 44
 6/19/79

MISSISSIPPI
 BOARD OF WATER COMMISSIONERS
 416 North State Street
 Jackson, Mississippi 39201

CODED

WATER WELL DRILLERS LOG

June 19, 1979 Dixie Water Well Pump Inc. Pearl River
 date well completed firm name county well located

| LANDOWNER: | description of formations encountered | from | to |
|--|---------------------------------------|------|-----|
| Bobbie Anderson Pt. 1 - Box 1 Poplarville, Mo. 39470 (mailing address) | Red Sand | 0 | 58 |
| WELL LOCATION: sec. 35 T 3 N R 18 E S W 3 miles South of Cross Roads (distance) (direction) (nearest town) | White Clay | 58 | 88 |
| WELL PURPOSE: Home (home, irrigation, municipal, industrial) | Blue Clay | 88 | 145 |
| WELL COMPLETION DATA: | Gray Sand | 145 | 200 |
| (1) diameter (inches) 4" | | | |
| (2) total depth (feet) 200' | | | |
| (3) static water level (feet) 63' below top of ground. | | | |
| (4) casing P.V.C. 180' (material) (depth) 4" (size) if telescope see back. | | | |
| (5) screen 20' 200' (length) (depth to top) 4" P.V.C. (size) (material) | | | |
| (6) pump 1 30 (HP) (yield gpm) Electric (type power) | | | |
| (7) electric log no (yes or no) (organization running log) | | | |
| (8) how well bottom plugged Sand pack | | | |

CODED

Miss. Board of Water Comm.


JUN 21 1979

RECEIVED

DRILLERS REMARKS:

If well telescopes please sketch and show depths.

GROUND LEVEL

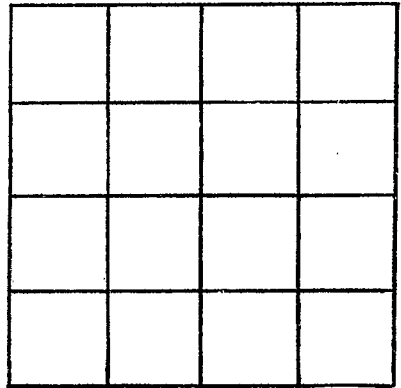

SECTION _____

Please indicate well location X.

ADDITIONAL INFORMATION

If more than one screen,
show locations of each on sketch.