

PEARL RIVER
J-45

MISSISSIPPI
BOARD OF WATER COMMISSIONERS
416 North State Street
Jackson, Mississippi 39201

CODED

WATER WELL DRILLERS LOG

10/11/79

10/11

1979 Bud Porter

Pearl River

date well completed

firm name

county well located

LANDOWNER: J.B. Seal

P.O. Box 149

Poplarville Miss.
(mailing address)

WELL LOCATION:

sec. 4 T. 3 S. R. 18 W.
15 miles W of Poplarville
(distance) (direction) (nearest town)

WELL PURPOSE: home
(home, irrigation, municipal, industrial)

WELL COMPLETION DATA:

- (1) diameter (inches) 2"
- (2) total depth (feet) 883
- (3) static water level (feet) 12 1/2' above top of ground
- (4) casing galv. 863
(material) (depth)
(size) if telescope see back.
- (5) screen 2x20 863
(length) (depth to top)
12' steel
(size) (material)
- (6) pump 1/2
(HP) (yield gpm)
(type power)
- (7) electric log no
(yes or no)

(organization running log)

(8) how well bottom plugged
Sand/Gravel

DRILLERS REMARKS:

description of formations encountered

from to

white shale	0	70
white sand	70	70
blue shale	70	115
blue sand	115	165
blue shale	165	240
blue sand	240	285
blue shale	285	340
gray sand	340	883

CODED


DEPT. OF NATURAL RESOURCES
BUREAU OF LAND & WATER RESOURCES

MAY 19 1980

RECEIVED

If well telescopes please sketch and show depths.

GROUND LEVEL

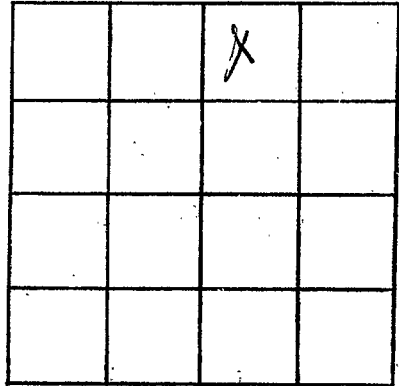

SECTION _____

Please indicate well location X.

ADDITIONAL INFORMATION

Lined area for additional information.

If more than one screen, show locations of each on sketch.