

MISSISSIPPI DEPARTMENT OF NATURAL RESOURCES

Bureau of Land and Water Resources

Southport Mall

P.O. Box 10631

Jackson, Mississippi 39209

WATER WELL DRILLERS LOG

W. BUD PENTON & SON
WATER WELL SERVICE

ROUTE 3 BOX 41

HARRISBURG, MISS 39426

PHONE 798-5324

Pearl River
county well located

Pearl River
K64
6-25-81

J51

6/25 1981
date well completed

LANDOWNER: *Ray DeFosse*
R. J. 3 Box 128
Poplarville Miss
(mailing address)

description of formations encountered	from	to
<i>white shale</i>	<i>0</i>	<i>60</i>
<i>blue sand</i>	<i>60</i>	<i>90</i>
<i>blue shale</i>	<i>90</i>	<i>128</i>
<i>blue sand</i>	<i>128</i>	<i>500</i>
<i>blue shale</i>	<i>500</i>	<i>580</i>
<i>gray sand</i>	<i>580</i>	<i>621</i>

WELL LOCATION:
sec. *X* T. *3* N. R. *18* W.
17 miles *West* of *Poplarville*
(distance) (direction) (nearest town)


WELL PURPOSE: *pearl*
(home, irrigation, municipal, industrial)

WELL COMPLETION DATA:

- (1) diameter (inches) *2"*
- (2) total depth (feet) *621*
- (3) static water level (feet) *6* below above top of ground.
- (4) casing *pvc* *621*
(material) (depth)
- _____ if telescope see back.
(size)
- (5) screen *2x30* *591*
(length) (depth to top)
- 12* *pvc*
(size) (material)
- (6) pump *no* _____
(HP) (yield gpm)
- _____ (type power)
- (7) electric log *no* _____
(yes or no)
- _____ (organization running log)

NENE S12 T3S R18W

Handwritten mark

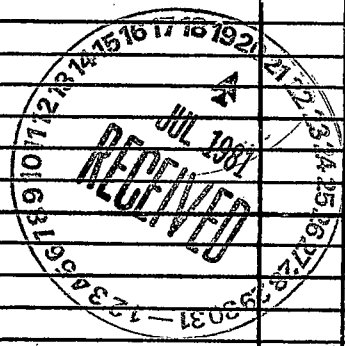


(8) how well bottom plugged _____

DRILLERS REMARKS: *Done*
Shark

If well telescopes please sketch and show depths.

GROUND LEVEL

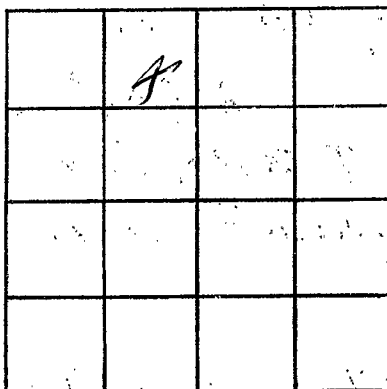

SECTION _____

Please indicate well location X.

ADDITIONAL INFORMATION

If more than one screen,
show locations of each on sketch.