

MISSISSIPPI DEPARTMENT OF NATURAL RESOURCES

Bureau of Land and Water Resources

Southport Mall

P.O. Box 10631

Jackson, Mississippi 39209

WATER WELL DRILLERS LOG

CODED

PEARL RIVER
J 52

2 3 87 19 JERRY L. SMITH PEARL RIVER
date well completed firm name county well located

LANDOWNER: C. JARRELL
ROUT 1 BOX
POPHARVIAH
(mailing address)

WELL LOCATION:
sec. 15 T. 3 N. R. 18 E.
AT CROSS ROADS WEST
(distance) miles (direction) of (nearest town)

WELL PURPOSE:
(home, irrigation, municipal, industrial)

WELL COMPLETION DATA:
(1) diameter (inches) 4" x 2"
(2) total depth (feet) 330
(3) static water level (feet) 24" below/above top of ground.
(4) casing PVC 330
(material) (depth)
2 if telescope see back.
(size)
(5) screen 20 330
(length) (depth to top)
2 PVC
(size) (material)
(6) pump 1/2 9
(HP) (yield gpm)
(type power)
(7) electric log _____
(yes or no)
(organization running log)
(8) how well bottom plugged VALVE

description of formations encountered	from	to
SANDY SOIL	0	3'
CLAY	3	18
SAND	18	27
GRAVEL	27	70
SAND	70	85
LARGE GRAVEL	85	100
CLAY	100	190
SAND FINE BLUE	190	210
CLAY	210	300
BLUE SAND	300	330

HAD TROUBLE WITH GRAVEL AT 80'

RECEIVED


JUN 16 1987

Department of Natural Resources
Bureau of Land & Water Resources

DRILLERS REMARKS: WERE A LOT OF GRAVEL

If well telescopes please sketch and show depths.

GROUND LEVEL

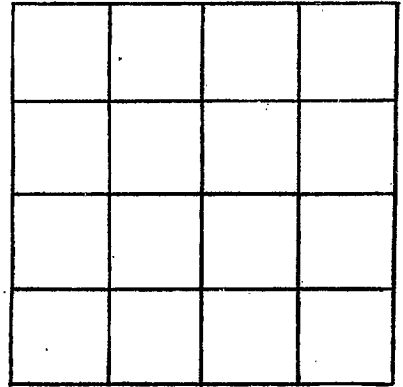

SECTION _____

Please indicate well location X.

ADDITIONAL INFORMATION

If more than one screen,
show locations of each on sketch.