

MISSISSIPPI DEPARTMENT OF NATURAL RESOURCES

Bureau of Land and Water Resources

Southport Mall

P.O. Box 10631

Jackson, Mississippi 39209

WATER WELL DRILLERS LOG

P. RIVER
J 54

CODED

8-19-1992 Bud Penton Water Well Pearl River
date well completed firm name county well located

LANDOWNER: Ray Powell
Rt 1 Box 1596 Poplarville
Ms 39470
(mailing address)


WELL LOCATION:
sec. 4 T. 3 N. R. 18 E.
3 miles N of Crossroads
(distance) (direction) (nearest town)

WELL PURPOSE: Home
(home, irrigation, municipal, industrial)

WELL COMPLETION DATA:

- (1) diameter (inches) 5
- (2) total depth (feet) 886
- (3) static water level (feet) flow ~~below~~ above top of ground.
- (4) casing PVC 770
(material) (depth)
2" if telescope see back.
(size)
- (5) screen 15 771
(length) (depth to top)
2" PVC
(size) (material)
- (6) pump _____ (HP) _____ (yield gpm)
(type power)
- (7) electric log no
(yes or no)
(organization running log)
- (8) how well bottom plugged sandshank

description of formations encountered	from	to
white shale	0	5
red gravel	5	35
white shale	35	80
white sand	80	95
blue shale	95	231
white sand	231	300
blue shale	300	395
GRAY SAND	395	410
blue shale	410	490
gray sand	490	580
blue shale	580	820
GRAY SAND	820	886

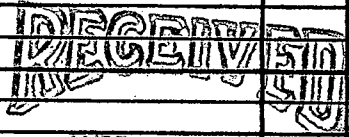

SEP 18 1992

Dept. of Environmental Quality
Bureau of Land & Water Resources

DRILLERS REMARKS:

If well telescopes please sketch and show depths.

GROUND LEVEL

X			

SECTION 4

Please indicate well location X.

ADDITIONAL INFORMATION

If more than one screen,
show locations of each on sketch.