

MISSISSIPPI DEPARTMENT OF ENVIRONMENTAL QUALITY

Office of Land and Water Resources

P. O. Box 10631

Jackson, MS 39289-0631

WATER WELL DRILLERS LOG

COUNTY WELL LOCATED
PEARL RIVER

WELL NUMBER
5-62

CODED

DATE WELL COMPLETED
8/15/05

PERMIT NUMBER
0-519

NAME OF DRILLING FIRM
BURGESS SERVICE

NAME & MAILING ADDRESS OF LANDOWNER
MICHAEL FRANK MILLE
601-403-8441 CARRIERS DR.
26 OBERSLEY ALEXANDER RD.

Latitude:
Longitude:

WELL LOCATION SEC TOWNSHIP RANGE
12 3 N 18 E W

DISTANCE DIRECTION NEAREST TOWN
Miles of

OTHER LANDMARK:
10 miles South of Pearlville

WELL PURPOSE: Home, Irrigation, Municipal, Industrial, Fish Pond, etc.

PUMP DATA

PUMP TYPE (Circle One):
Submersible, Turbine, Jet Flowing Well,
Other (Describe)

POWER TYPE (Circle One):
Electric, Tractor, Diesel, Gasoline, Butane,
Other (Describe) 1HP H/P

DESCRIPTION OF FORMATIONS ENCOUNTERED	FROM	TO
RED DIRT	0	10
WHITE CLAY	10	15
WHITE SAND	15	35
WH. TE CLAY	35	45
SAND	45	65
WH. TE CLAY	65	145
ROCK'S	145	160

Top of Lap Pipe or Reduction in Casing

FEET IF TELESCOPED OR MORE THAN ONE SCREEN: USE BACK PAGE

WELL DATA

Well Depth 160	Casing Diameter (In.) 2	Casing Length (Ft.) 160
Type of Casing PVC	Hole Depth 160	Depth to Static Water Level 25'

TYPE OF COMPLETION: (Circle One or More):
Gravel Packed, Underreamed, Telescoped,
Natural Development, Open Hole, Other
(Describe) AIR

WELL GROUTED TO A DEPTH OF **10 FEET**
Type Grout (circle one): Cement Bentonite, or Mix

SCREEN DATA

Diameter - Inches 2	Length - Feet 20	Slot Size - Inches #10
Screen Type SLOT	Depth to Bottom - Feet 160	

I certify that the well was drilled, constructed and completed in accordance with all applicable Requirements of the Mississippi Department of Environmental Quality and/or the Mississippi Department of Health regulations and state laws.

RECEIVED
MAR 16 2006 **8/15/05**


Signature of Licensed Driller and License No. **0-519** BY: **OLWR** Date

Additional Information Required On Back

If well telescopes please sketch and show depths.

GROUND LEVEL

*HATE DUE TO HURRICANE
KATRINA
TOOK OUT MY HOUSE
& SHED*

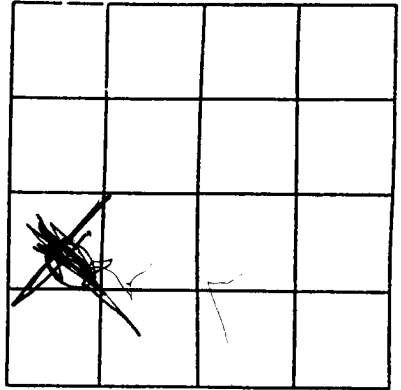

SECTION _____

Please indicate well location X.

Pump Capacity (GPM)	No. of Stages	Setting Depth	FT.
---------------------	---------------	---------------	-----

PUMP TEST

Well yielded _____ GPM with
a drawdown of _____ ft.
after _____ hours of pumping

LOG DATA

TYPE OF LOG RUN (Circle One): No Log Run, Electric, Gamma Ray, Density, Sonic, Neutron, Other (Describe) _____

Name of Organization Running Log _____

GEOLOGIC DATA (Office Use Only)

Surface Elev.	Geologic Unit	Unit Thickness	Depth to Top
Subs. SWL	Date	Analysis	Aquifer Test

Driller's Remarks

If more than one screen, show location of each on sketch.