

*COPY*

Pearl River  
J 2000  
Oct 11, 1976

MISSISSIPPI  
BOARD OF WATER COMMISSIONERS  
416 North State Street  
Jackson, Mississippi 39201

WATER WELL DRILLERS LOG

10-11 1976 R. Woodward Drilling Pearl River  
date well completed firm name county well located

LANDOWNER: Harold Collins  
Bogalusa, La. 70427  
  
(mailing address)

description of formations encountered	from	to
<u>yellow clay</u>	<u>0</u>	<u>22'</u>
<u>fine sand</u>	<u>22</u>	<u>37'</u>
<u>gray clay</u>	<u>37</u>	<u>68'</u>
<u>Fine gray sand</u>	<u>68</u>	<u>82'</u>
<u>light brown sand</u>	<u>82</u>	<u>92'</u>

WELL LOCATION:  
sec. 13 T. 3 S. R. 18 W.  
1 1/2 miles NE of Crossroads  
(distance) (direction) (nearest town)

WELL PURPOSE: Home  
(home, irrigation, municipal, industrial)

WELL COMPLETION DATA:

- (1) diameter (inches) 4"
- (2) total depth (feet) 92'
- (3) static water level (feet) 60' below above top of ground.
- (4) casing PVC 82'  
(material) (depth)  
4"  
(size) if telescope see back.
- (5) screen 10' 82'  
(length) (depth to top)  
4" x .015 PVC  
(size) (material)
- (6) pump 1/2 7  
(HP) (yield gpm)  
230V AC  
(type power)
- (7) electric log NO  
(yes or no)

(organization running log)


(8) how well bottom plugged float  
Type B.W.V.

DRILLERS REMARKS:

**RECEIVED**  
**APR 4 1977**  
MISS. BD. OF WATER COMMISSIONERS

If well telescopes please sketch and show depths.

GROUND LEVEL

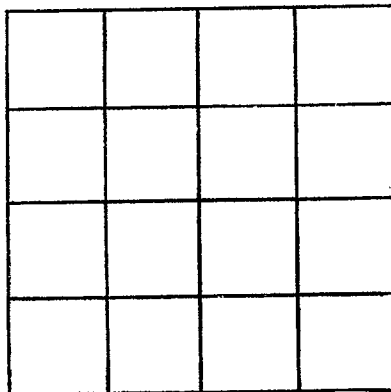

SECTION \_\_\_\_\_

Please indicate well location X.

ADDITIONAL INFORMATION

If more than one screen, show locations of each on sketch.