

PEARL RIVER

J 2002

9-25-78

MISSISSIPPI
 BOARD OF WATER COMMISSIONERS
 416 North State Street
 Jackson, Mississippi 39201

WATER WELL DRILLERS LOG

Sept. 25, 1978 date well completed
 1978 *Shim Water Well & Pump, Inc.* firm name
Pearl River county well located

LANDOWNER: <i>Norrell Kimball</i>	description of formations encountered	from	to
<i>RE.</i>			
<i>Poplarville, Ms 39470</i> (mailing address)	<i>Yellow Clay</i>	<i>0</i>	<i>15'</i>
	<i>White & Pink Sand</i>	<i>15'</i>	<i>35'</i>
WELL LOCATION: sec. <i>35</i> T. <i>3</i> N. R. <i>18</i> E. S. <i>5</i> W. <i>4</i>	<i>White Clay</i>	<i>35'</i>	<i>88'</i>
<i>4</i> miles <i>South</i> of <i>CROSSROADS</i> (distance) (direction) (nearest town)	<i>Blue Clay</i>	<i>88'</i>	<i>118'</i>
WELL PURPOSE: <i>HOME</i> (home, irrigation, municipal, industrial)	<i>White Coarse Sand</i>	<i>118'</i>	<i>148'</i>


WELL COMPLETION DATA:

- (1) diameter (inches) 2"
- (2) total depth (feet) 148'
- (3) static water level (feet) 90 ^{below} _{above} top of ground.
- (4) casing P.V.C. 138'
(material) (depth)
2" If telescope see back.
(size)
- (5) screen 10' 148'
(length) (depth to top)
.012 P.V.C.
(size) (material)
- (6) pump 1 7
(HP) (yield gpm)
Electric
(type power)
- (7) electric log no
(yes or no)

(organization running log)

(8) how well bottom plugged
Sand Shark


DRILLERS' REMARKS:

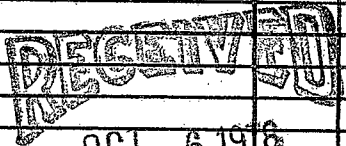

MISS. BD. OF WATER COMM

If well telescopes please sketch and show depths.

GROUND LEVEL

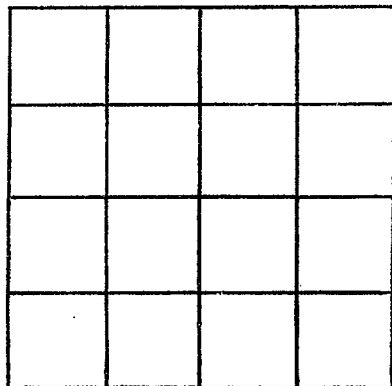

SECTION _____

Please indicate well location X.

ADDITIONAL INFORMATION

If more than one screen, show locations of each on sketch.