

PEARL RIVER

J 2003

11-04-78

MISSISSIPPI BOARD OF WATER COMMISSIONERS 416 North State Street Jackson, Mississippi 39201

WATER WELL DRILLERS LOG

11-4-1978 Pearl River water well Pearl River county well located

LANDOWNER: A. G. PERRY RT I BOX 174 CARRIERS, MISS 39426 (mailing address)

Table with 3 columns: description of formations encountered, from, to. Entries include Top clay, fine sand, shells, fine sand & gravel, water sand.

WELL LOCATION: sec. 36 T 3 N R 18 E 1/4 miles (distance) S of (direction) of Crossroad (nearest town)

WELL PURPOSE: Home (home, irrigation, municipal, industrial)


- WELL COMPLETION DATA: (1) diameter (inches) 16" (2) total depth (feet) 265' (3) static water level (feet) 182 below top of ground. (4) casing PVC, 253' (depth) (5) screen 10' (length), 255' (depth to top) (6) pump 1 (HP), 20 (yield gpm) (7) electric log (yes or no) (8) how well bottom plugged 2" sand - 5' depth

RECEIVED JAN 23 1978 MISS. BD. OF WATER COMMISSIONERS

DRILLERS REMARKS:

If well telescopes please sketch and show depths.

GROUND LEVEL

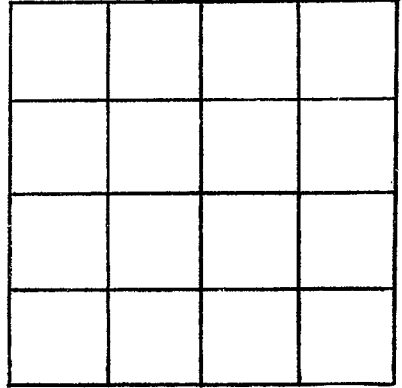

SECTION _____

Please indicate well location X.

ADDITIONAL INFORMATION

If more than one screen, show locations of each on sketch.