

Pearl River
 T 2004
 4-30-80

MISSISSIPPI
 BOARD OF WATER COMMISSIONERS
 416 North State Street
 Jackson, Mississippi 39201

WATER WELL DRILLERS LOG

4-30-1980 date well completed
 Staffed well Sr Pearl River firm name
 county well located

LANDOWNER:

Agnes Martin

(mailing address)

WELL LOCATION:

sec 3 T 3 N 2 R 18 E
 13 miles EW of Poplarville

WELL PURPOSE:

(home, irrigation, municipal, industrial)

WELL COMPLETION DATA:

- (1) diameter (inches) 4"
- (2) total depth (feet) 80
- (3) static water level (feet) 40 below top of ground
- (4) casing (material) (depth) 76
 4" If telescope see back.
- (5) screen 70 ft 76
 (length) (depth to top)
 4" plastic
 (size) (material)
- (6) pump 1/2 12
 (HP) (yield gpm)
 Elect
 (type power)
- (7) electric log (yes or no)

(organization running log)

(8) how well bottom plugged BWU

description of formations encountered	from	to
top	0	2
sand clay	2	20
fine sand	20	30
coarse sand & gravel	30	80

DRILLERS REMARKS:

[Signature]


DEPT OF NATURAL RESOURCES
 BUREAU OF LAND & WATER RESOURCES

MAY 27 1980

RECEIVED

If well telescopes please sketch and show depths.

GROUND LEVEL

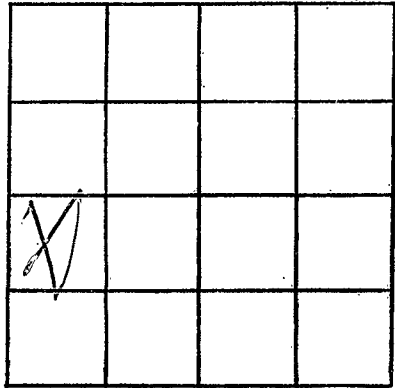

SECTION _____

Please indicate well location X.

ADDITIONAL INFORMATION

If more than one screen,
show locations of each on sketch.