

PEARL RIVER
J 2005

MISSISSIPPI
BOARD OF WATER COMMISSIONER
416 North State Street
Jackson, Mississippi 39201



2-14-81

WATER WELL DRILLERS LOG

2/14 1981 81 Bud Porter Water Well Drilling firm name
date well completed county well located

LANDOWNER: Mr & Mrs Ferguson
B.T. 3 Box 180
Picayune Miss.
(mailing address)

description of formations encountered	from	to
<u>Red shale</u>	<u>0</u>	<u>13</u>
<u>Red sand</u>	<u>15</u>	<u>25</u>
<u>White shale</u>	<u>25</u>	<u>35</u>
<u>White sand</u>	<u>35</u>	<u>105</u>

WELL LOCATION:
sec. 13 T. 3 N. R. 18 E.
0.8 miles (distance) W (direction) of Picayune (nearest town)


WELL PURPOSE: home
(home, irrigation, municipal, industrial)

- WELL COMPLETION DATA:
- (1) diameter (inches) 4"
 - (2) total depth (feet) 115
 - (3) static water level (feet) 54 below above top of ground.
 - (4) casing pvc 115
(material) (depth)
(size) if telescope see back.
 - (5) screen 10 105
(length) (depth to top)
12 pvc
(size) (material)
 - (6) pump 1/2 750
(HP) (yield gpm)
Elect
(type power)
 - (7) electric log no
(yes or no)
 - (organization running log)
 - (8) how well bottom plugged hard
sharp

DRILLERS REMARKS:

If well telescopes please sketch and show depths.

GROUND LEVEL

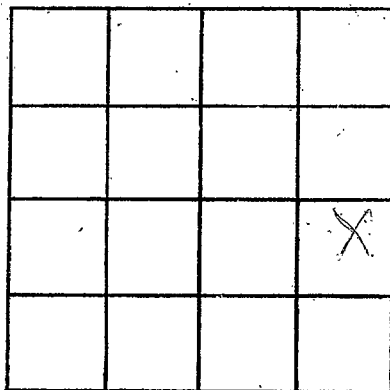

SECTION _____

Please indicate well location X.

ADDITIONAL INFORMATION

If more than one screen, show locations of each on sketch.