

PEARL RIVER
 T 2006
 2/25/81
 Feb. 25

MISSISSIPPI
 BOARD OF WATER COMMISSIONERS
 416 North State Street
 Jackson, Mississippi 39201

WATER WELL DRILLERS LOG

date well completed 1981
 firm name Divers Water Well Pump Pearl River
 county well located

LANDOWNER: Alvin Davis

POPLARVILLE, MISS.
 (mailing address)

WELL LOCATION:

sec. 24 T 3 S R. 18 W
1/4 miles W Poplarville
 (distance) (direction) (nearest town)

WELL PURPOSE:

(home, irrigation, municipal, industrial)

WELL COMPLETION DATA:


- (1) diameter (inches) 4"
- (2) total depth (feet) 155
- (3) static water level (feet) 53 below top of ground.
- (4) casing plastic, 145'
 (material) (depth)
9 If telescope see back.
 (size)
- (5) screen 10', 145'
 (length) (depth to top)
4", plastic
 (size) (material)
- (6) pump 1, 15
 (HP) (yield gpm)
230V AC
 (type power)
- (7) electric log NO
 (yes or no)
SELF
 (organization running log)
- (8) how well bottom plugged 2"55

description of formations encountered	from	to
Red clay	0	16
fine white sand	17	24
white clay	24	49
fine Red sand	50	60
sand & iron gravel	60	80
clay	80	119
Chum sand & gravel	119	155

DRILLERS REMARKS:

If well telescopes please sketch and show depths.

GROUND LEVEL

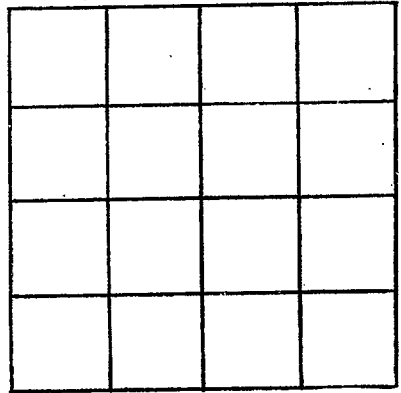

SECTION _____

Please indicate well location X.

ADDITIONAL INFORMATION

If more than one screen, show locations of each on sketch.