

MISSISSIPPI DEPARTMENT OF NATURAL RESOURCES

Bureau of Land and Water Resources

Southport Mall

P.O. Box 10631

Jackson, Mississippi 39209

BUD BENTON & SON
WATER WELL SERVICE DRILLERS LOG

ROUTE 3 BOX 41
CARRIERE, MS 39426

PHONE 780-5924

Pearl Rv
J 2008
6-27-81

6/27 1981
date well completed

Pearl River
county well located

LANDOWNER: Don Smith

R.T. 3 Poplarville

Miss (mailing address)

| description of formations encountered | from | to |
|---------------------------------------|------|-----|
| Red Shale | 0 | 65 |
| Red Sand | 65 | 105 |
| White Shale | 105 | 165 |
| Blue sand | 165 | 200 |

WELL LOCATION:

sec. 1 T. 3 N R. 18 E
1.5 miles West of Poplarville
(distance) (direction) (nearest town)

WELL PURPOSE: Dom
(home, irrigation, municipal, industrial)


WELL COMPLETION DATA:

- (1) diameter (inches) 2"
- (2) total depth (feet) 200
- (3) static water level (feet) 33 below above top of ground.
- (4) casing PVC 200
(material) (depth)
_____ if telescope see back.
(size)
- (5) screen 10 190
(length) (depth to top)
12 PVC
(size) (material)
- (6) pump 200 _____
(HP) (yield gpm)

(type power)
- (7) electric log no
(yes or no)


(organization running log)
- (8) how well bottom plugged hard
shard

DRILLERS REMARKS:

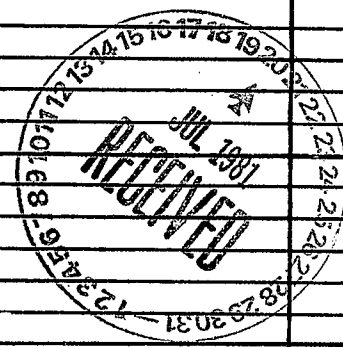

If well telescopes please sketch and show depths.

GROUND LEVEL

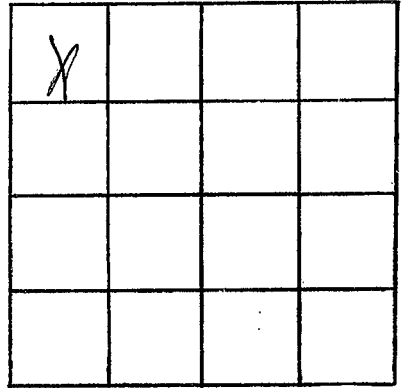

SECTION _____

Please indicate well location X.

ADDITIONAL INFORMATION

If more than one screen,
show locations of each on sketch.