

MISSISSIPPI DEPARTMENT OF NATURAL RESOURCES

Bureau of Land and Water Resources

Southport Mall

P.O. Box 10631

Jackson, Mississippi 39209

WATER WELL DRILLERS LOG

Pearl River  
J 2009  
7-24-81

July 24 1981 Clear Water Authority Pearl River  
 date well completed from name county well located  
Robert L. Schmidt

LANDOWNER: Mrs. Mary Mitchell

description of formations encountered	from	to
---------------------------------------	------	----

(mailing address)


<u>top soil</u>	<u>0"</u>	<u>2"</u>
<u>real clay</u>	<u>2"</u>	<u>1'</u>
<u>real sand gravel 1/2"</u>	<u>1'</u>	<u>10'</u>
<u>well sand real gravel</u>	<u>10'</u>	<u>27'</u>

WELL LOCATION:  
 sec 16 T 3 N R 18 E  
1.9 miles W of Crosswood  
 (distance) (direction) (nearest town)

WELL PURPOSE: home  
 (home, irrigation, municipal, industrial)

WELL COMPLETION DATA:


(1) diameter (inches) 2  
 (2) total depth (feet) 27'  
 (3) static water level (feet) 13 below above top of ground.  
 (4) casing PVC 27'  
 (material) (depth)  
 \_\_\_\_\_ if telescope see back.  
 (size)  
 (5) screen 18 17  
 (length) (depth to top)  
2 1/2 PVC  
 (size) (material)  
 (6) pump 1/2 8  
 (HP) (yield gpm)  
110 V AC  
 (type power)  
 (7) electric log \_\_\_\_\_  
 (yes or no)  
 \_\_\_\_\_  
 (organization running log)  
 (8) how well bottom plugged PVC Cap.

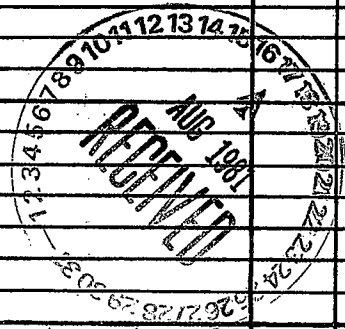

DRILLERS REMARKS:

If well telescopes please sketch and show depths.

GROUND LEVEL

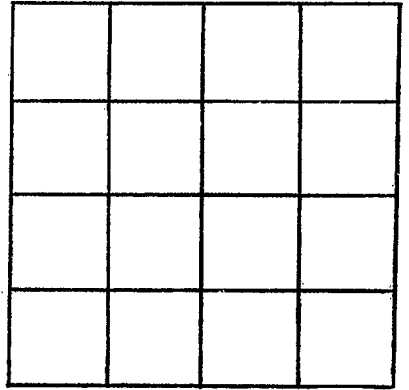

SECTION \_\_\_\_\_

Please indicate well location X.

ADDITIONAL INFORMATION

If more than one screen, show locations of each on sketch.