

MISSISSIPPI DEPARTMENT OF NATURAL RESOURCES

Bureau of Land and Water Resources

Southport Mall

P.O. Box 10631

Jackson, Mississippi 39209

WATER WELL DRILLERS LOG

Dead River
2010 J

11-15-82 19 Walker Wellbros Dead River
date well completed firm name county well located

LANDOWNER: <u>Harvey Fee</u>	description of formations encountered	from	to
<u>RT-1 Box 181C</u>	<u>red shale</u>	<u>0</u>	<u>20</u>
<u>Cameron Miss</u> (mailing address)	<u>fine sand</u>	<u>20</u>	<u>42</u>
WELL LOCATION:	<u>white chalk</u>	<u>42</u>	<u>85</u>
sec <u>35</u> T <u>3</u> N R <u>18</u> S	<u>blue shale</u>	<u>85</u>	<u>150</u>
<u>3</u> miles <u>S</u> of <u>2684</u> (distance) (direction) (nearest town)	<u>sand</u>	<u>150</u>	<u>210</u>
WELL PURPOSE: <u>Home</u> (home, irrigation, municipal, industrial)			
WELL COMPLETION DATA:			
(1) diameter (inches) <u>4"</u>			
(2) total depth (feet) <u>210'</u>			
(3) static water level (feet) <u>153</u> below top of ground.			
(4) casing <u>PVC</u> , <u>206</u> (material) (depth)			
(size) if telescope see back.			
(5) screen <u>10'</u> , <u>206</u> (length) (depth to top)			
(size) <u>12</u> , <u>PVC</u> (size) (material)			
(6) pump <u>3/4</u> , <u>8</u> (HP) (yield gpm)			
<u>elec</u> (type power)			
(7) electric log (yes or no)			
(organization running log)			
(8) how well bottom plugged <u>sand</u> <u>about</u>			
DRILLERS REMARKS:			


DEPT. OF NATURAL RESOURCES
BUREAU OF LAND & WATER RESOURCES

MAY 10 1982

RECEIVED

If well telescopes please
sketch and show depths.

GROUND LEVEL

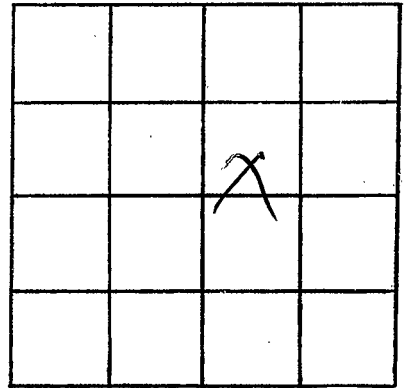

SECTION _____

Please indicate well location X.

ADDITIONAL INFORMATION

If more than one screen,
show locations of each on sketch.