

MISSISSIPPI DEPARTMENT OF NATURAL RESOURCES

Bureau of Land and Water Resources

Southport Mall

P.O. Box 10631

Jackson, Mississippi 39209

WATER WELL DRILLERS LOG

Pearl River
52011

avg 16 1982 Walker Welding Pearl River
 date well completed firm name county well located


LANDOWNER: <u>Gray Caron</u> <u>RH</u>	description of formations encountered	from	to
<u>Poplarville Miss</u> (mailing address)	<u>Gray shale</u>	<u>0</u>	<u>16</u>
WELL LOCATION: sec. <u>14</u> T. <u>2</u> N. R. <u>18</u> E. W. <u>3</u> <u>HV 26X43</u> of <u>Cuba</u> (distance) miles (direction) of (nearest town)			
WELL PURPOSE: <u>Home</u> (home, irrigation, municipal, industrial)			
WELL COMPLETION DATA:			
(1) diameter (inches) <u>4"</u>			
(2) total depth (feet) <u>52'</u>			
(3) static water level (feet) <u>16</u> below above top of ground.			
(4) casing <u>PVC</u> <u>42'</u> (material) (depth)			
_____ if telescope see back. (size)			
(5) screen <u>16'</u> <u>42'</u> (length) (depth to top)			
(6) pump <u>12</u> <u>PVC</u> (size) (material)			
(7) pump <u>1/2</u> <u>18</u> (HP) (yield gpm)			
<u>Elec</u> (type power)			
(7) electric log _____ (yes or no)			
_____ (organization running log)			
(8) how well bottom plugged <u>Good</u> <u>shrub</u>			
DRILLERS REMARKS: _____			

DEPT. OF NATURAL RESOURCES
 BUREAU OF LAND & WATER RESOURCES

AUG 23 1982
 RECEIVED

If well telescopes please
sketch and show depths.

GROUND LEVEL

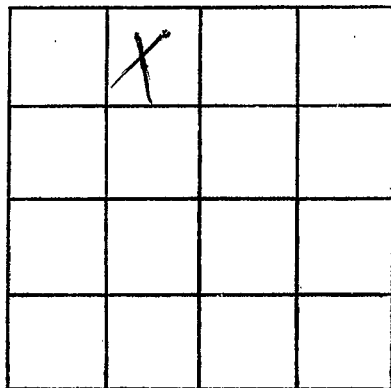

SECTION _____

Please indicate well location X.

ADDITIONAL INFORMATION

If more than one screen,
show locations of each on sketch.