

MISSISSIPPI DEPARTMENT OF NATURAL RESOURCES

Bureau of Land and Water Resources

Southport Mall

P.O. Box 10631

Jackson, Mississippi 39209

WATER WELL DRILLERS LOG

Paul Ruis
J 2014

Jan 6 1983 Walker Well Paul Ruis
date well completed firm name county well located

LANDOWNER: T.D. Wheat
Poplarville Miss
(mailing address)

description of formations encountered	from	to
<u>Sandy Red shale</u>	<u>0</u>	<u>36</u>
<u>Blue shale</u>	<u>36</u>	<u>37</u>
<u>Coarse Sand</u>	<u>37</u>	<u>cut</u>
<u>fine gravel</u>		

WELL LOCATION:
sec. 13 T. 2 S. R. 18 W.
6 miles N of Cross Road
(distance) (direction) (nearest town)

WELL PURPOSE: Home
(home, irrigation, municipal, industrial)

- WELL COMPLETION DATA:
- (1) diameter (inches) 2"
 - (2) total depth (feet) 64'
 - (3) static water level (feet) 04' below top of ground.
 - (4) casing PVC 64'
(material) (depth)
 - (size) if telescope see back.
 - (5) screen 10' 54'
(length) (depth to top)
 - 12 PVC
(size) (material)
 - (6) pump 1 10
(HP) (yield gpm)
 - Elec
(type power)
 - (7) electric log (yes or no) _____

(organization running log) _____

(8) how well bottom plugged Sand
shank

DRILLERS REMARKS: _____


DEPT. OF NATURAL RESOURCES
BUREAU OF LAND & WATER RESOURCES

JAN 11 1983

RECEIVED

If well telescopes please sketch and show depths.

GROUND LEVEL

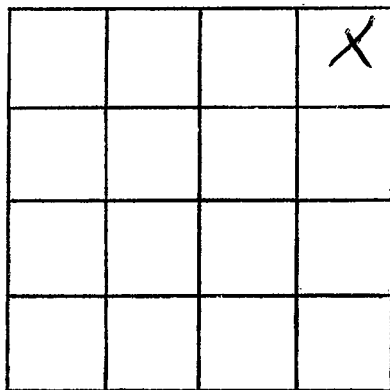

SECTION _____

Please indicate well location X.

ADDITIONAL INFORMATION

If more than one screen,
show locations of each on sketch.