

MISSISSIPPI DEPARTMENT OF NATURAL RESOURCES

Bureau of Land and Water Resources

Southport Mall

P.O. Box 10631

Jackson, Mississippi 39209

WATER WELL DRILLERS LOG

Pearl River
J 2015
5/10/83

May 10-83 date well completed
Walker Welding firm name
Pearl River county well located

LANDOWNER: <u>Ernie King</u>	description of formations encountered	from	to
<u>Part 1 Poplarville</u> (mailing address)	<u>Heavy sand</u> <u>sand</u>	<u>0</u> <u>10</u>	<u>10</u> <u>50</u>
WELL LOCATION: sec. <u>13</u> T. <u>3</u> N R. <u>18</u> E <u>1</u> miles <u>E</u> of <u>Cross Roads</u> (distance) (direction) (nearest town)			
WELL PURPOSE: <u>Home</u> (home, irrigation, municipal, industrial)			
WELL COMPLETION DATA:			
(1) diameter (inches) <u>2"</u>			
(2) total depth (feet) <u>50</u>			
(3) static water level (feet) <u>20</u> below top of ground.			
(4) casing <u>PVC</u> <u>40'</u> (material) (depth)			
_____ if telescope see back. (size)			
(5) screen <u>10'</u> <u>40'</u> (length) (depth to top)			
_____ <u>PVC</u> (size) (material)			
(6) pump <u>1/2</u> _____ (HP) (yield gpm)			
_____ (type power)			
(7) electric log _____ (yes or no)			
_____ (organization running log)			
(8) how well bottom plugged <u>sand</u> <u>slush</u>			
DRILLERS REMARKS: _____			


DEPT. OF NATURAL RESOURCES
BUREAU OF LAND & WATER RESOURCES

MAY 20 1983

RECEIVED

If well telescopes please
sketch and show depths.

GROUND LEVEL

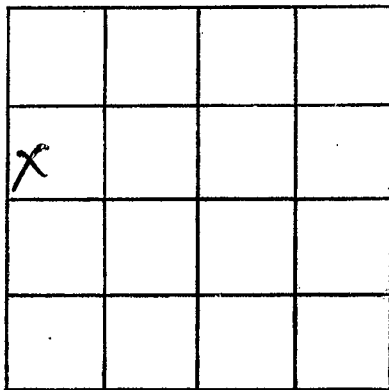

SECTION _____

Please indicate well location X.

ADDITIONAL INFORMATION

If more than one screen,
show locations of each on sketch.