

Pear River
82014

MISSISSIPPI DEPARTMENT OF NATURAL RESOURCES
Bureau of Land and Water Resources
Southport Mall
P.O. Box 10631
Jackson, Mississippi 39209
WATER WELL DRILLERS LOG

May 18 83 Walrus Welding Pear River
date well completed firm name county well located

LANDOWNER:
Lester Woodall
Poplarville Miss
(mailing address)

description of formations encountered	from	to
<u>Young Chalk</u>	<u>0</u>	<u>14</u>
<u>Sand & Gravel</u>	<u>14</u>	<u>58</u>

WELL LOCATION:
sec. 5 T. 3 N. R. 18 E.
2 miles N of 26 and 43
(distance) (direction) of 43 (nearest town)

WELL PURPOSE: Home
(home, irrigation, municipal, industrial)

- WELL COMPLETION DATA:
- (1) diameter (inches) 2 ¹¹
 - (2) total depth (feet) 58
 - (3) static water level (feet) 14 below top of ground.
 - (4) casing PVC, 48'
(material) (depth)
 - (size) If telescope see back.
 - (5) screen 10' , 48'
(length) (depth to top)
 - 12 , PVC
(size) (material)
 - (6) pump ND , _____
(HP) (yield gpm)
 - (type power)
 - (7) electric log _____
(yes or no)
 - (organization running log)
 - (8) how well bottom plugged Sand
check

DRILLERS REMARKS: _____


DEPT. OF NATURAL RESOURCES
BUREAU OF LAND & WATER RESOURCES

JUN 14 1983

RECEIVED

If well telescopes please
sketch and show depths.

GROUND LEVEL

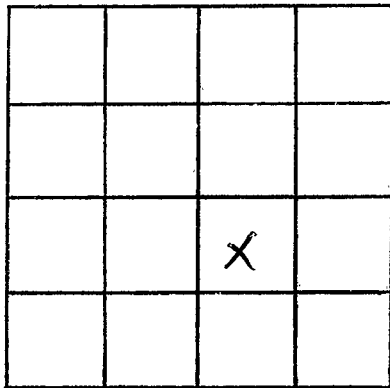

SECTION _____

Please indicate well location X.

ADDITIONAL INFORMATION

If more than one screen,
show locations of each on sketch.