

PEARL RIVER
J 2000

MISSISSIPPI DEPARTMENT OF NATURAL RESOURCES
Bureau of Land and Water Resources
Southport Mall
P.O. Box 10631
Jackson, Mississippi 39209
WATER WELL DRILLERS LOG

June 28 1984 date well completed
Walkers Well Drilling firm name
Pearl River county well located

LANDOWNER: Billy Davis
poplarville Miss
Cross Roads
(mailing address)

description of formations encountered	from to	
<u>limestone</u>	<u>0</u>	<u>12</u>
<u>sand & gravel</u>	<u>12</u>	<u>45</u>

WELL LOCATION:
sec. 14 T 3 N R 18 E
S W
Cross Roads 264 43
miles (distance) of (direction) (nearest town)

WELL PURPOSE: Home
(home, irrigation, municipal, industrial)

WELL COMPLETION DATA:


- (1) diameter (inches) 2"
- (2) total depth (feet) 45'
- (3) static water level (feet) 12 below above top of ground.
- (4) casing pvc 35'
(material) (depth)
- if telescope see back.
(size)
- (5) screen 10' 35'
(length) (depth to top)
- 18 pvc
(size) (material)
- (6) pump NO
(HP) (yield gpm)
- (type power)
- (7) electric log
(yes or no)
- (organization running log)
- (8) how well bottom plugged Sand
shells

DRILLERS REMARKS:

DEPT. OF NATURAL RESOURCES
BUREAU OF LAND & WATER RESOURCES
JUL 24 1984
RECEIVED

If well telescopes please sketch and show depths.

GROUND LEVEL

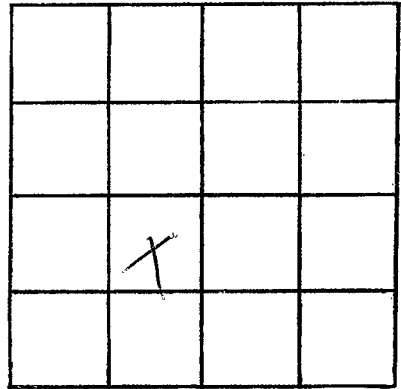

SECTION _____

Please indicate well location X.

ADDITIONAL INFORMATION

If more than one screen,
show locations of each on sketch.