

BOARD OF WATER COMMISSIONERS
416 North State Street
Jackson, Mississippi 39201

Pearl River
9 2021

WATER WELL DRILLERS LOG

9-17-84 19 *R. Cotton's Drilling* *Pearl River*
date well completed firm name county well located

LANDOWNER: *C. J. Peterson, Rt. 1 Poplarville, Miss.*
(mailing address)

description of formations encountered	from	to
<i>Chalky clay</i>	<i>0</i>	<i>60'</i>
<i>Water bearing sand</i>	<i>60</i>	<i>80</i>

WELL LOCATION: *T 35 R 18 S 2 T 35 R 18*
of Crossroads, Miss.
(distance) miles (direction) of (nearest town)

WELL PURPOSE: *home*
(home, irrigation, municipal, industrial)

WELL COMPLETION DATA:

- (1) diameter (inches) *4 in.*
- (2) total depth (feet) *80*
- (3) static water level (feet) *50* below top of ground.
- (4) casing *4 in.* (material) (depth)
- (size) if telescope see back.
- (5) screen *10'* (length) (depth to top)
- 4* (size) *plc* (material)
- (6) pump *1/2* (HP) (yield gpm)
- 220* (type power)
- (7) electric log (yes or no)
- (organization running log)

(8) how well bottom plugged *L.W. valve*

DRILLERS REMARKS:


DEPT. OF NATURAL RESOURCES
BUREAU OF LAND & WATER RESOURCES

OCT 29 1984

RECEIVED

If well telescopes please
sketch and show depths.

GROUND LEVEL

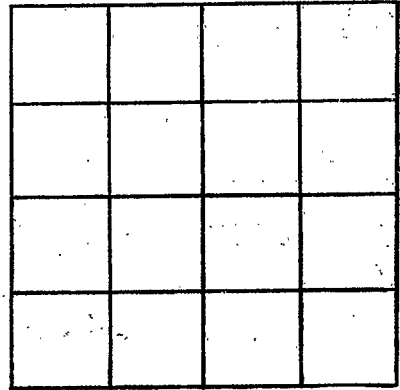

SECTION _____

Please indicate well location X.

ADDITIONAL INFORMATION

If more than one screen,
show locations of each on sketch.