

MISSISSIPPI DEPARTMENT OF NATURAL RESOURCES

Bureau of Land and Water Resources

Southport Mall

P.O. Box 10631

Jackson, Mississippi 39209

WATER WELL DRILLERS LOG

PEARL RIVER
J 2023

5-29-1985 WALKERS WELDING PR
date well completed firm name county well located

LANDOWNER: TROY FLOWERS
RT. 2
POPLARVILLE, MS.
(mailing address)

description of formations encountered	from	to
<u>CLAY</u>	<u>0</u>	<u>15</u>
<u>SAND & GRAVEL</u>	<u>15</u>	<u>54</u>

WELL LOCATION:
sec. 11 T 3 S R 18 E
16 miles W of POPLARVILLE
(distance) (direction) (nearest town)

WELL PURPOSE: HOME
(home, irrigation, municipal, industrial)

- WELL COMPLETION DATA:
- (1) diameter (inches) 2
 - (2) total depth (feet) 54
 - (3) static water level (feet) 16 below top of ground.
 - (4) casing Pvc 54
(material) (depth)
(size) if telescope see back.
 - (5) screen Pvc 44
(length) (depth to top)
2" Pvc
(size) (material)
 - (6) pump 1/2 8
(HP) (yield gpm)
ELEC.
(type power)
 - (7) electric log (yes or no)
(organization running log)
 - (8) how well bottom plugged 3 and 1/2 inch

RECEIVED


JUN 25 1985

DRILLERS REMARKS:

Department of Natural Resources
Bureau of Land & Water Resources

If well telescopes please sketch and show depths.

GROUND LEVEL

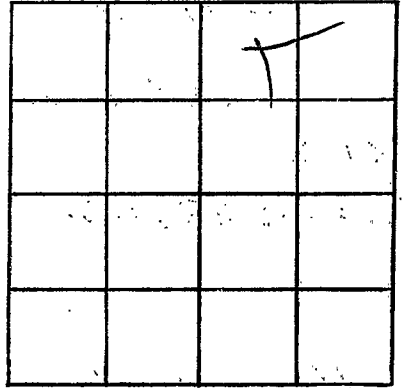

SECTION _____

Please indicate well location X.

ADDITIONAL INFORMATION

If more than one screen,
show locations of each on sketch.