

MISSISSIPPI DEPARTMENT OF NATURAL RESOURCES

Bureau of Land and Water Resources

Southport Mall

P.O. Box 10631

Jackson, Mississippi 39209

WATER WELL DRILLERS LOG

Pearl River  
J 2024

16 12 85 date well completed Jerry L. Smith firm name Pearl River county well located

LANDOWNER: J. L. Smith  
Rout 1 Box 249  
Poplarville Miss  
(mailing address)

WELL LOCATION:  
sec. 15 T 3 N R 18 E  
EAST OF HW 430 AT CROSSROADS  
(distance) miles (direction) of (nearest town)

WELL PURPOSE:  
(home, (irrigation) municipal, industrial)

WELL COMPLETION DATA:

(1) diameter (inches) 4

(2) total depth (feet) 330

(3) static water level (feet) 1 below above top of ground.

(4) casing PVC 300  
(material) (depth)

4 if telescope see back.  
(size)

(5) screen 30  
(length) (depth to top)

PVC  
(size) (material)

(6) pump 5 40  
(HP) (yield/gpm)

GAS 114  
(type power)

(7) electric log yes or no  
(organization running log)

(8) how well bottom plugged EAST  
WAVE

description of formations encountered	depth	
	from	to
TOP SOIL	0	2
CLAY	2	20
SAND & GRAVEL	20	95
<del>SAND</del> CLAY	95	185
SAND & GRAVEL	185	200
HARD CLAY	200	300
BLUE SAND	300	330


RECEIVED  
NOV 20 1985

Department of Natural Resources  
Bureau of Land & Water Resources

DRILLERS REMARKS:

If well telescopes please sketch and show depths.

GROUND LEVEL

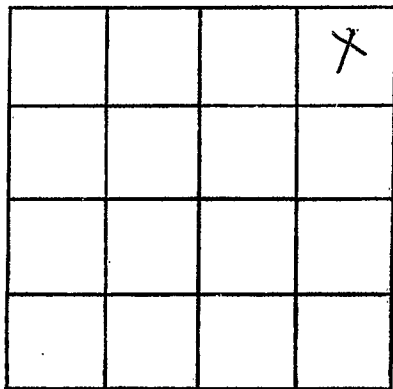

SECTION 16

Please indicate well location X.

ADDITIONAL INFORMATION

WELL WAS PUMPED  
WITH A SUCTION  
LIFT PUMP

DRAWN 18"

Pumping 40 G.P.M.

If more than one screen,  
show locations of each on sketch.