

Pearl River
J 2006

MISSISSIPPI DEPARTMENT OF NATURAL RESOURCES
 Bureau of Land and Water Resources
 Southport Mall
 P.O. Box 10631
 Jackson, Mississippi 39209
WATER WELL DRILLERS LOG

March 27, 19 86 Walkers Welding Pearl River
 date well completed firm name county well located

LANDOWNER: James Rawls
Poplarville

(mailing address)

WELL LOCATION:

sec. 26 T 3 N R 18 E
23 miles NW of Picayune
 (distance) (direction) (nearest town)

WELL PURPOSE: Home
 (home, irrigation, municipal, industrial)

WELL COMPLETION DATA:

- (1) diameter (inches) 4"
- (2) total depth (feet) 236'
- (3) static water level (feet) 80' below above top of ground.
- (4) casing PVC 226'
 (material) (depth)
 if telescope see back.
 (size)
- (5) screen 10' 226'
 (length) (depth to top)
#10 PVC
 (size) (material)
- (6) pump 1/2 8
 (HP) (yield gpm)
Electric
 (type power)
- (7) electric log
 (yes or no)

 (organization running log)
- (8) how well bottom plugged Sand Shark

description of formations encountered	from	to
Sand	0	20
Clay	20	90
Sand	90	100
Clay	100	175
Sand	175	236


TO BE SET WITHIN 30 DAYS
APR 29 1966

Department of Natural Resources
 Bureau of Land and Water Resources

DRILLERS REMARKS:

If well telescopes please
sketch and show depths.

GROUND LEVEL

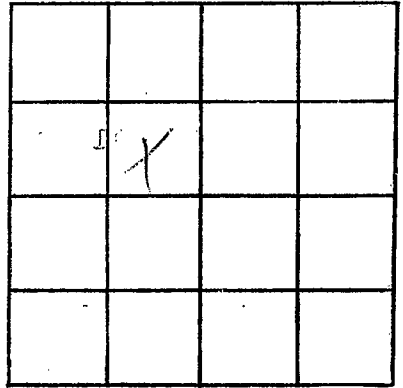

SECTION _____

Please indicate well location X.

ADDITIONAL INFORMATION

If more than one screen,
show locations of each on sketch.